


May 9-1906

Passesown line

Lincoln lot 22-423  
22nd St. v.

City Eng. office  
47

Block Dist = 662.04  
Lots = 132.408  
Blk 37 A.

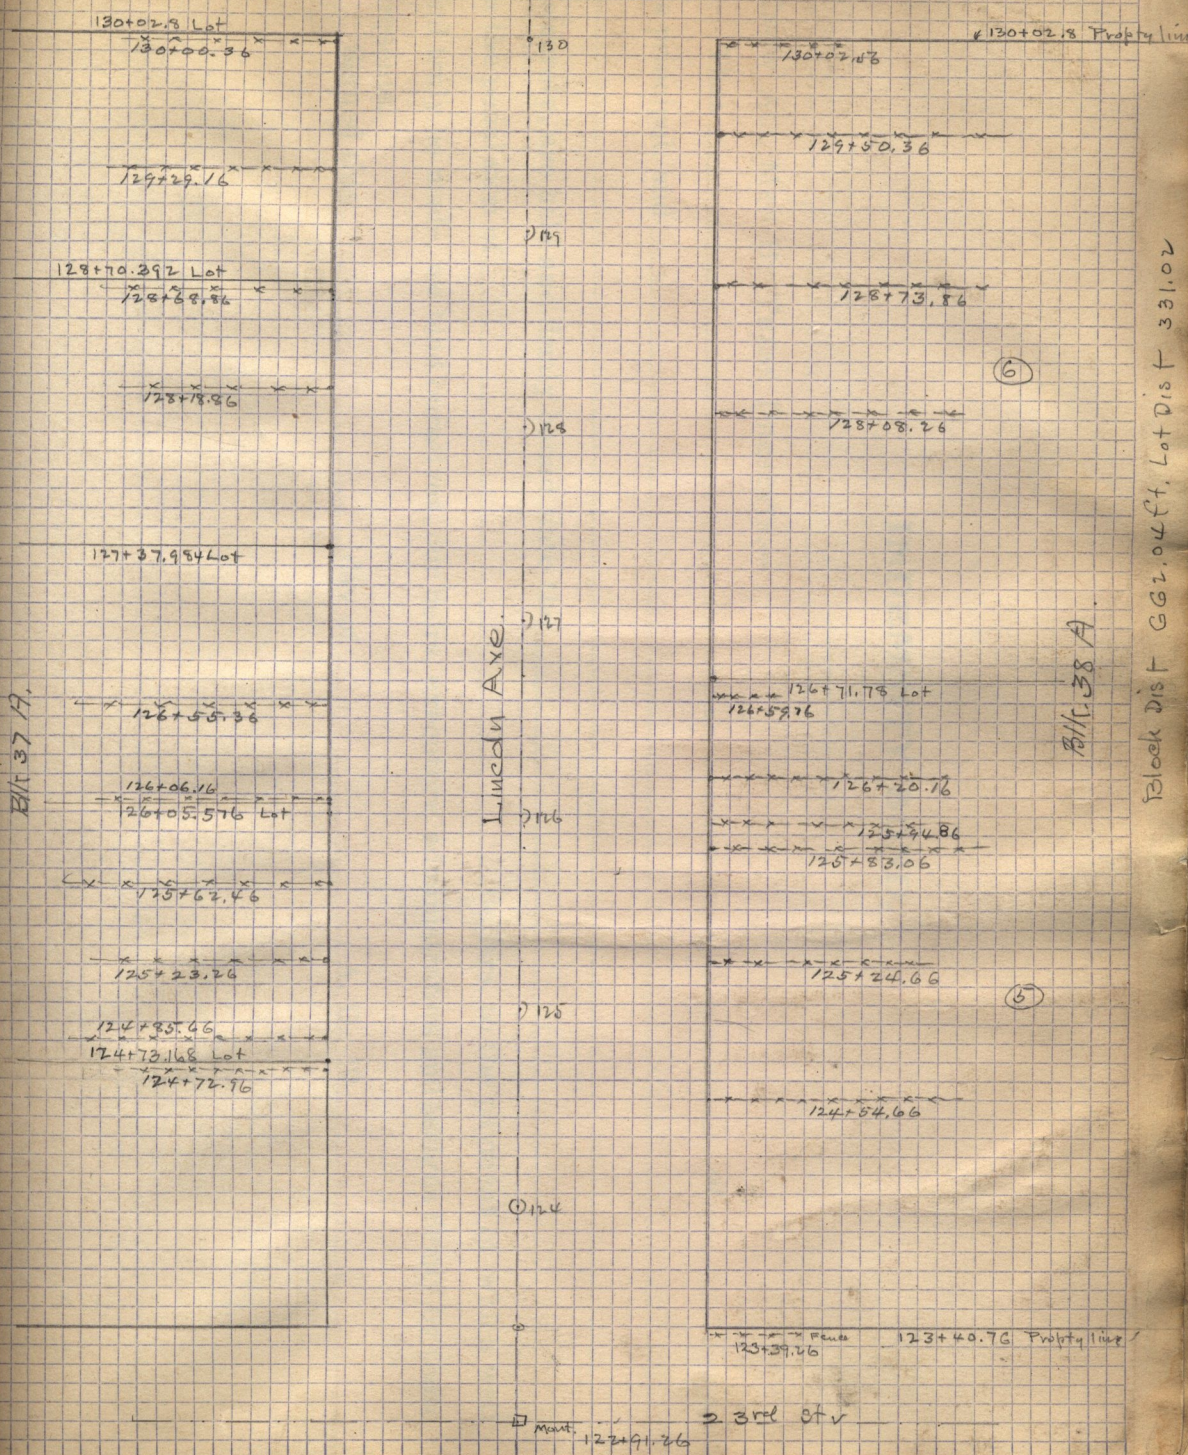

Blk 38 A

Block Dist 662.04 ft, Lot Dist 331.02

Lincoln Ave.

23rd St v