


To be conveyed by James Macle & wife
 To D.H. Perry Estate & Dora Perry Macle. N 84° 10' E
 174.66
 = calculated

N 0° 08' E


 & deeding to each owner his interest therein



To be conveyed by
 D.H. Perry Estate in part
 to James Macle.

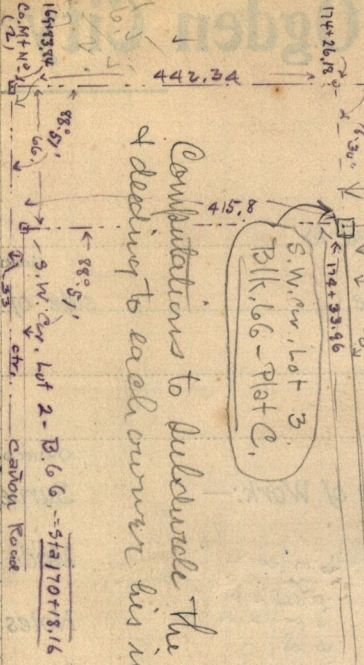

Canyon Road
 S.W. 1/4

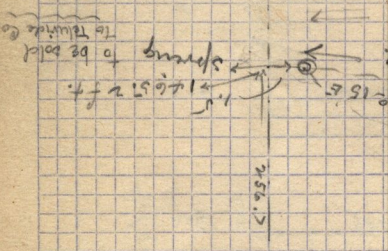

10' x 10' x 6' rock
 ground
 5.7' x 5'

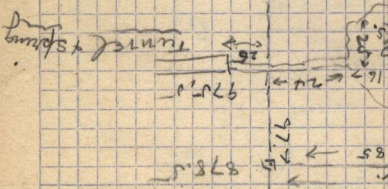

 15 line of Lot 3-Block 16 C.

58A

