July 15 – 1906 – Survey for Frank Moore at North Ogden
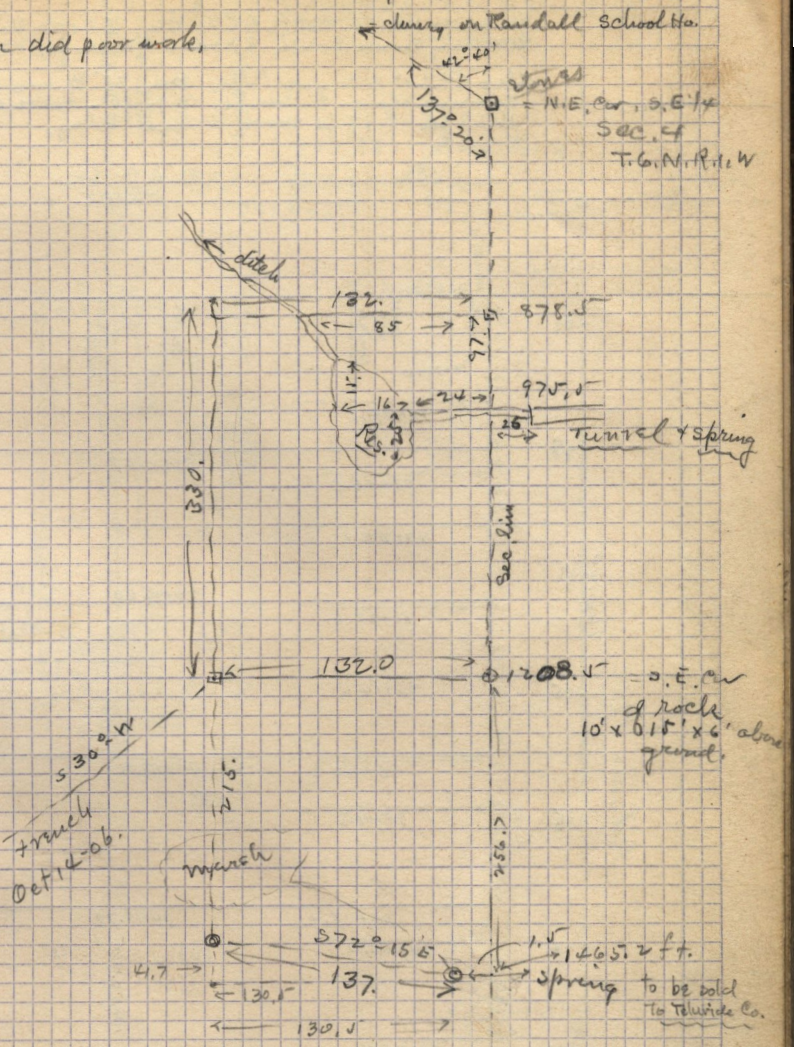
Frank Moore & Orton Chairmen did poor work.