


Possessory or Fence lines in Block 13-Plat A

July 18-1906.
 edw-deed Willard Scowcraft & wife to Sara A. Mc Cure -

Pt. Lot 7 - Blk. 13. Plat A. O.C.S. Beg. 15 rods N. of N.E. cor. of said lot.
 Running thence South 8 rods - W 66. ft. N's Dredg E 66. ft. to beg.

also Pt. Lot 8 same Blk. Beg. 35' N. and 16 1/2 ft E. of S.W. cor. of said lot.
 Running thence E 66. ft. N 97. ft - more or less to the N. line of said lot.
 W. 66 ft S 97. ft more or less to beg.

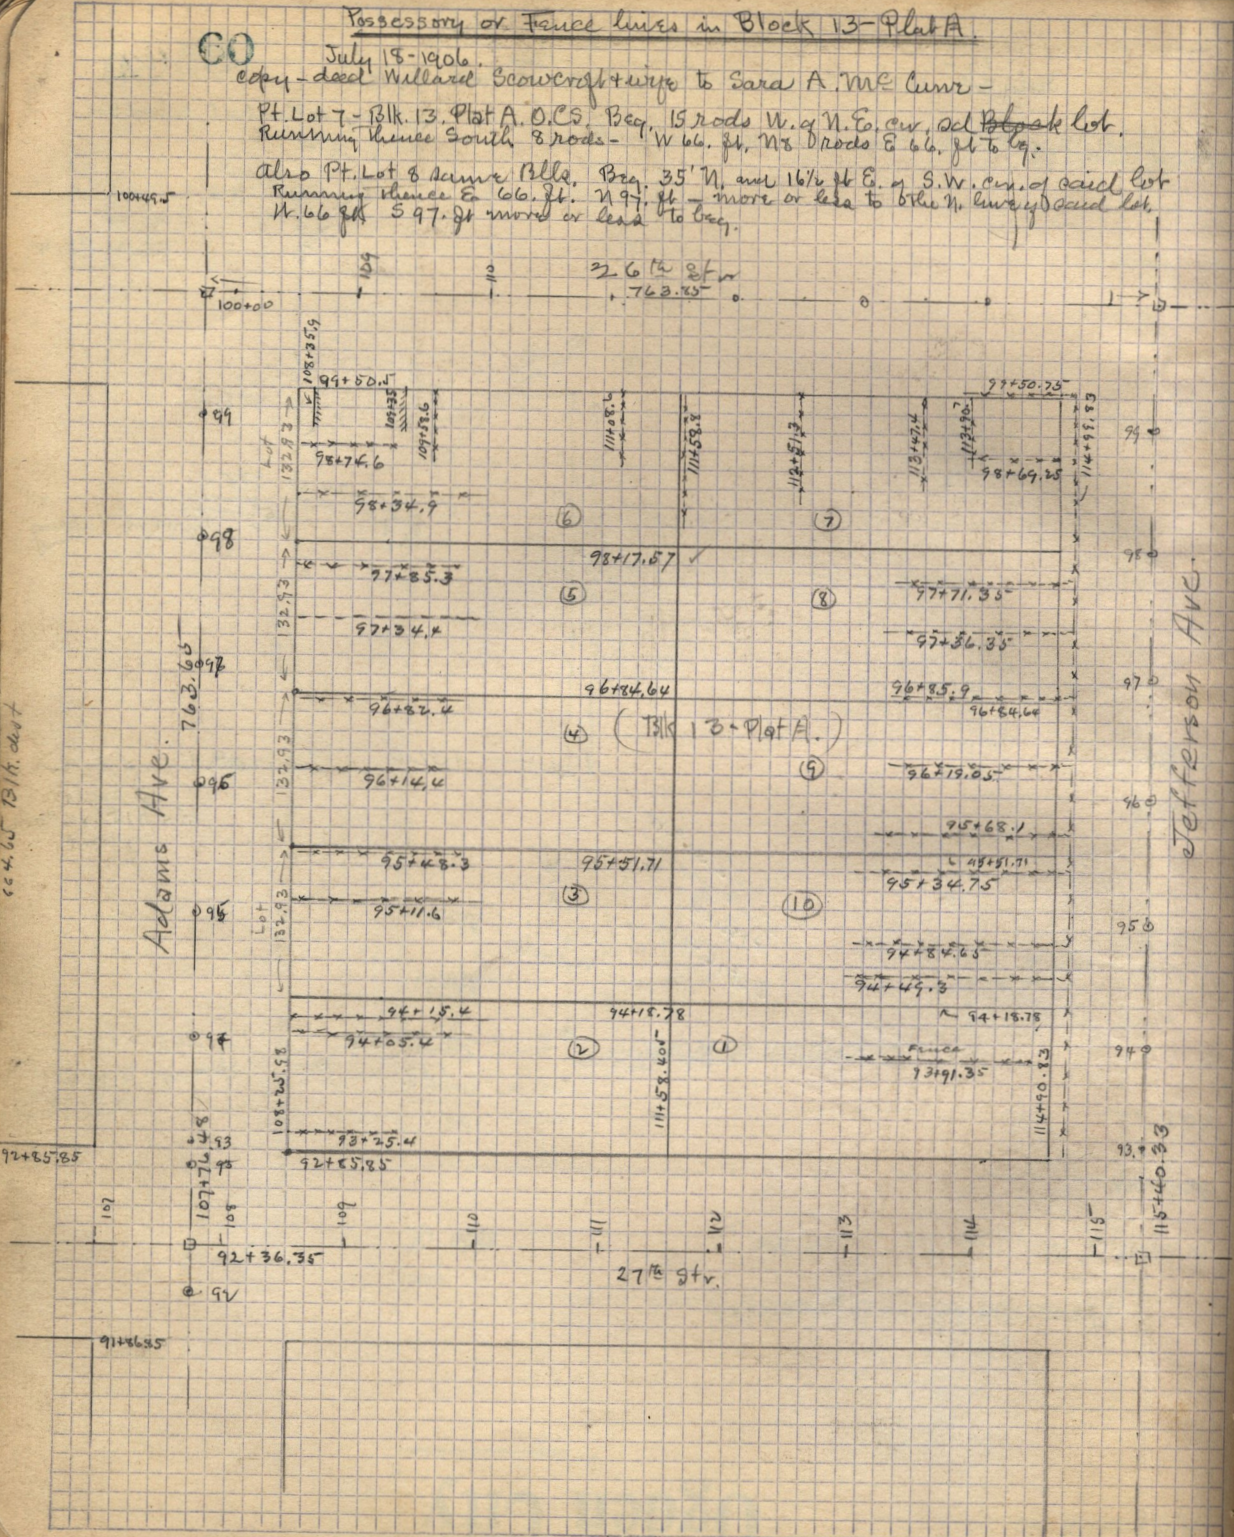

cc 4.65 151 ft. dist

