

July 27-06.

Survey for Sara A. Mc Curie

61

For possession lines in this block
see page 60

111x88.405 - 60

111+77.33

112+43.33


763.66 = measured today

763.85 - short dead

381.925

Hub.

Mont.

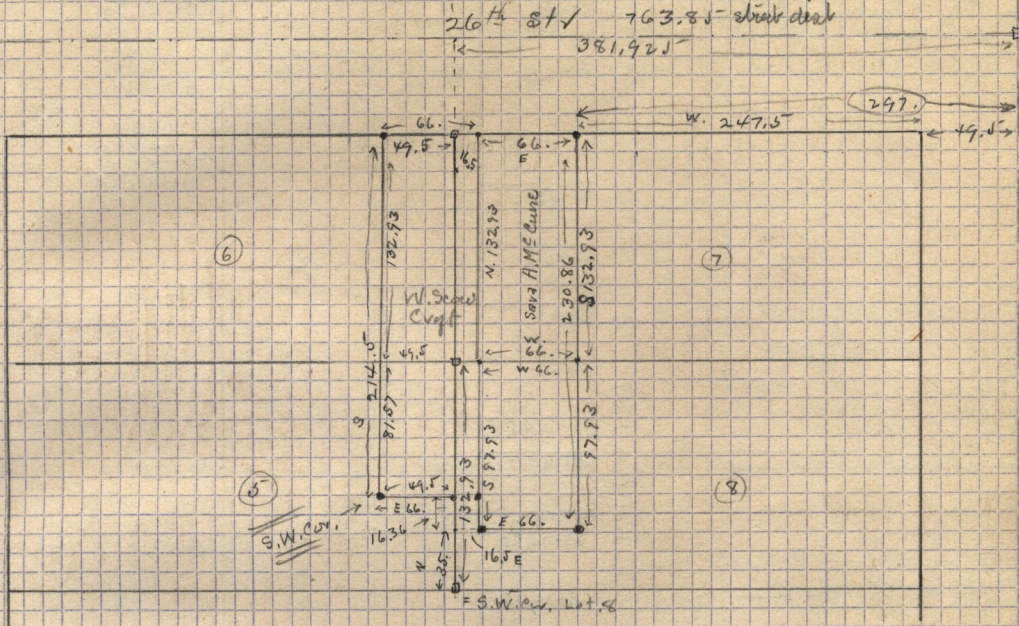

Steff.

Adams

