Aug. 19th 1906 Sunday Self W. A. Harrop & Bert Griffith

Survey for T. Irwin of land described on page 64 This book (also page 91 " ")

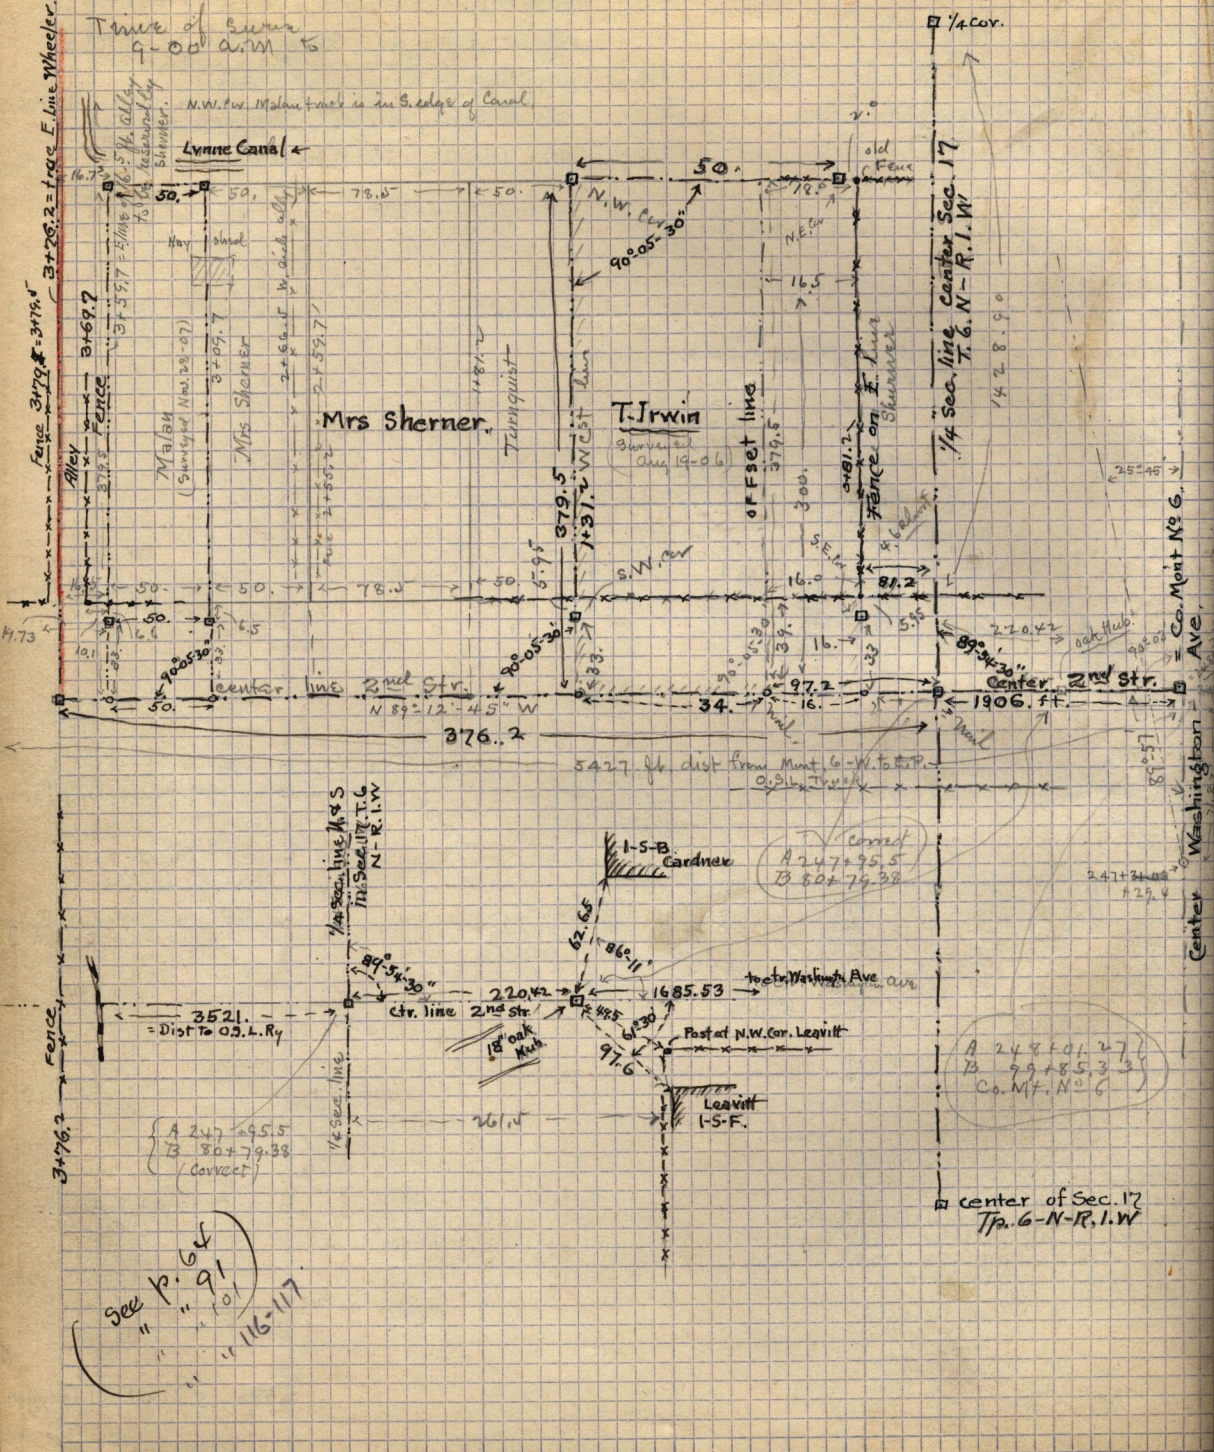

See p. 64
" " 91
" " 101
" " 116-117