


Aug 29th 1906

Survey of Huntsville Cemetery self + W. A. Harbo, I

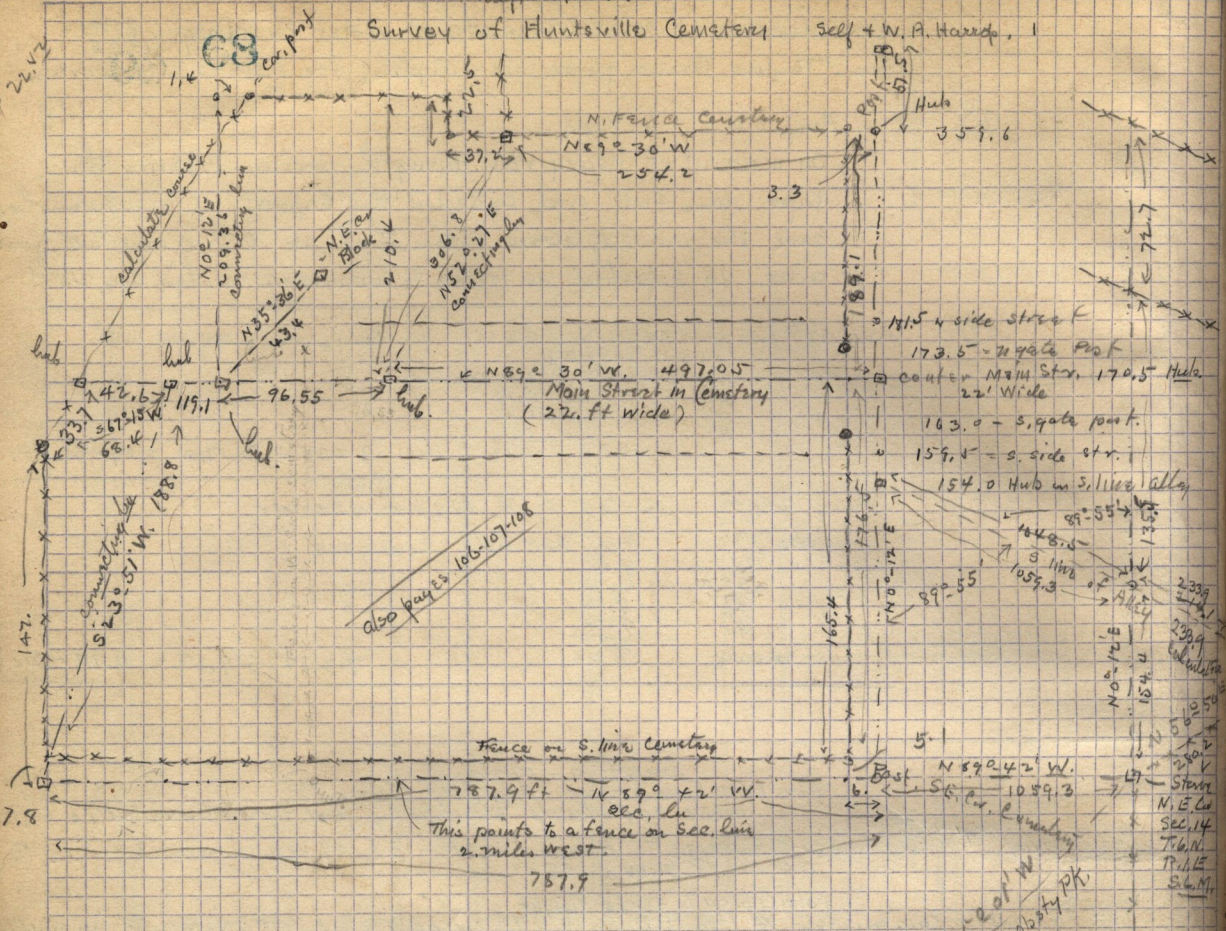

Sept 1-1906 - 1/2 day

Traverse Table of tract adjoining the N. side of Cemetery (page 69) for purpose of closing the description beg. at S.E. cor. of same.

course	dist	N	S	E	W
N 0° 12' E	57.5 ft	57.5			
N 69° 46' W	277.5			0.2	
S 0° 12' W	152.1				
S 89° 42' E	260.7				

Traverse table of total boundaries of Cemetery beg. 1320. f. N 59° 42' W. of S.E. cor. Sec. 11.

S 89° 42' E	260.7	1.4	260.7		
N 0° 12' E	154.0			.5	
S 89° 42' E	1293.2		6.3	1293.2	
N 60° 05' W	66.7				57.8
N 89° 42' W	1169.3				1169.3
N 0° 12' E	206.2				0.7
N 65° 46' W	347.7				326.2
S 0° 12' W	511.7				1.8
	519.4	511.7			
	519.4	1555.1		1555.1	

Copy of deed J. C. Wangsgaard to Huntsville City.

51
200

deed J. C. Wangsgaard to Huntsville City - Pt. Lot 5-Block 12 - Plat A, Huntsville Survey - Beg. at N.W. cor. of lot - E 74.5 ft - S 132. ft - W 74.5 ft - N 132.0 ft. to beg.

49
452

Wm Slater to J. C. Wangsgaard - Pt. Lot 5-Block 12, Huntsville Survey, Beg. 24 ft. W. of N.E. cor. of lot. S 60 ft. E 24 ft. S. to S.E. cor. of lot W. to S.W. cor. of lot N + N.W. cor. of lot