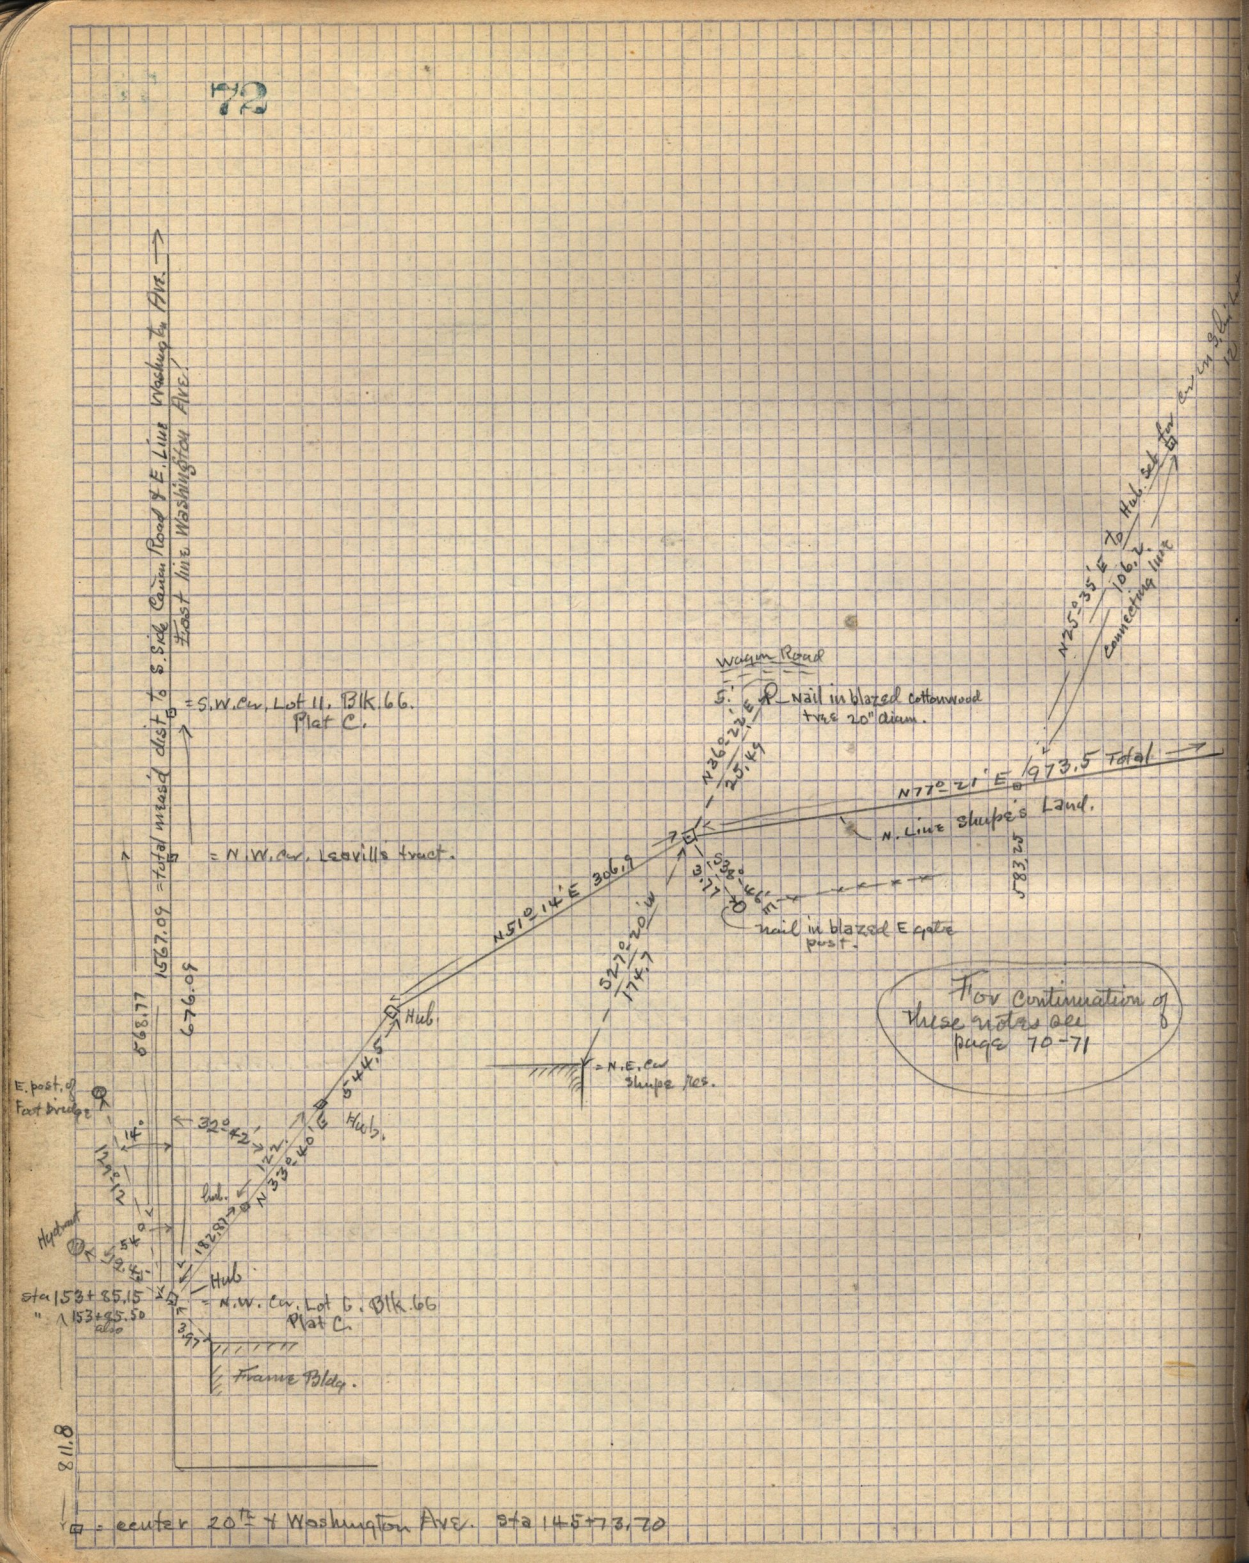
East line Washington Ave.
= S.W. Cor. Lot 11, Blk. 66. Plat C.
= N.W. Cor. Leaville tract.
676.08
N 51° 14' E 306.9
Hub.
Hub.
E. post of East bridge
Hydrant
sta 153+85.15
" 153+85.50 also
Hub.
= N.W. Cor. Lot 6, Blk 66 Plat C.
Frame Bldg.
811.8
= center 20th & Washington Ave. sta 145+73.70
Waiyum Road
5' R Nail in blazed cottonwood tree 20" diam.
N 36° 23' E 25.44
N 77° 21' E 973.5 Total
N. Line Shupe's Land.
N 25° 35' E 10.6' to Hub. set for center line
10.6' Connecting line
S 83° 25' E
Nail in blazed E gate post.
S 27° 20' W 17.47
= N.E. Cor. Shupe Res.
For continuation of these notes see page 70-71