


72


(72D)

Tp. 6 N - R. 3 W. → ← Tp. 6 N - R. 2 W.

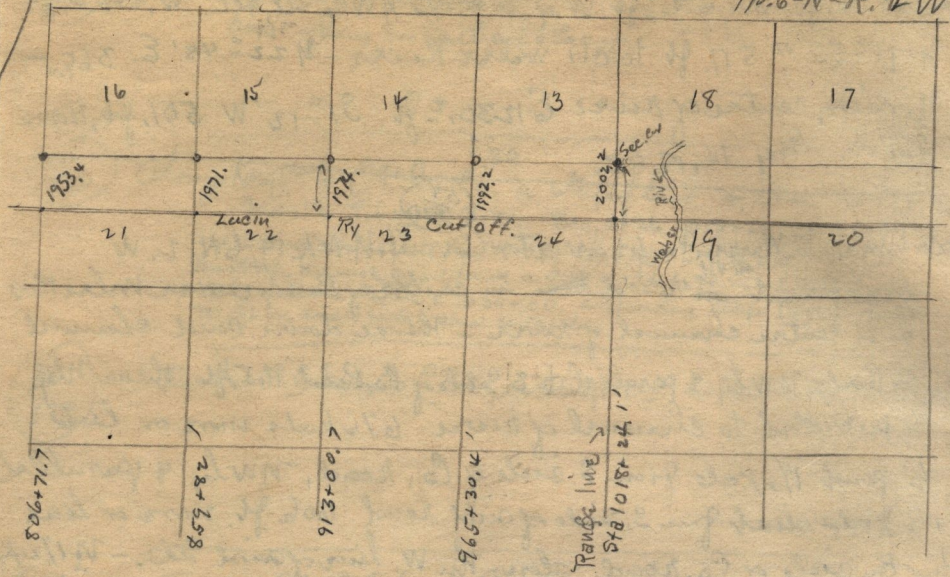

→ S. Side Center Road & E. Line Washington Ave. →
 → East line Washington Ave.
 = S.W. Cor. Lot 11, Plat
 = N.W. Cor. Lot

→ = total meadow dist. →
 858.77
 1567.09
 676.09

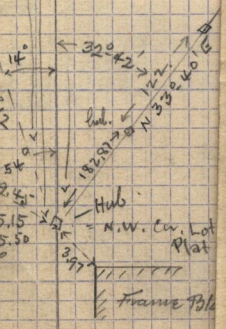

center 20. = 4 Was