Sept 9-1906.

Survey for Huntsville City Corporation and J. C. Wangs-agent
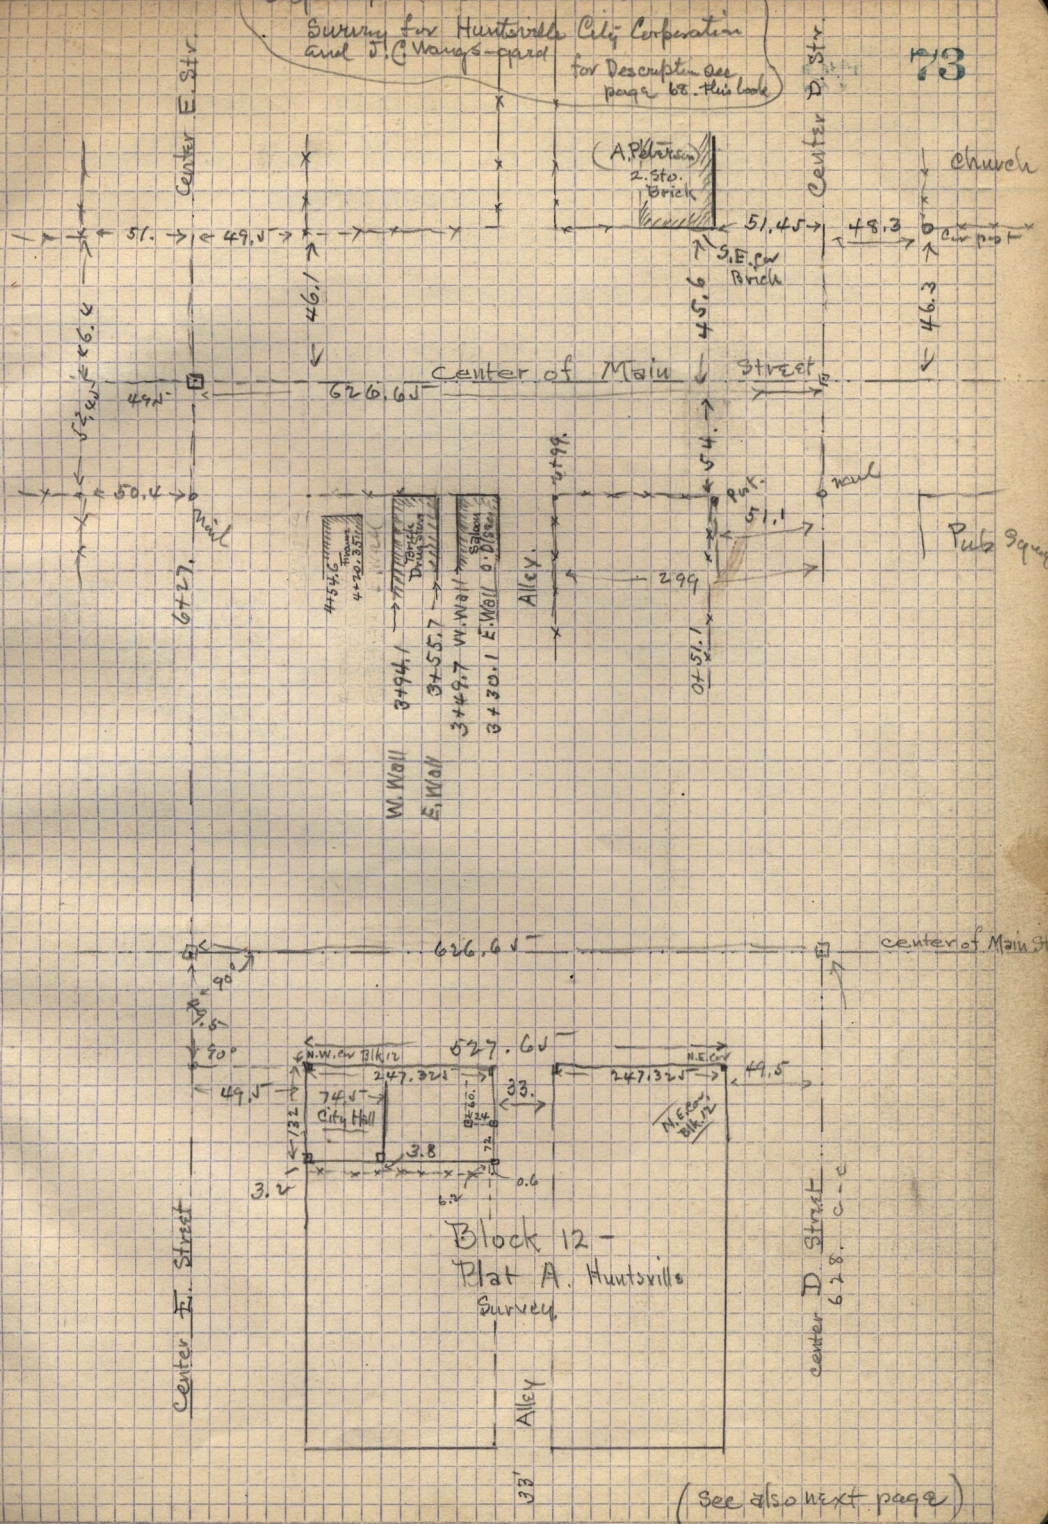
for Description see page 68. Plat book