Self. W. A. Harrob. & Wm. Gravel.
1 day

Survey for Huntsville City Corporation & for J. C. Waugspack

(Continued from page 73)

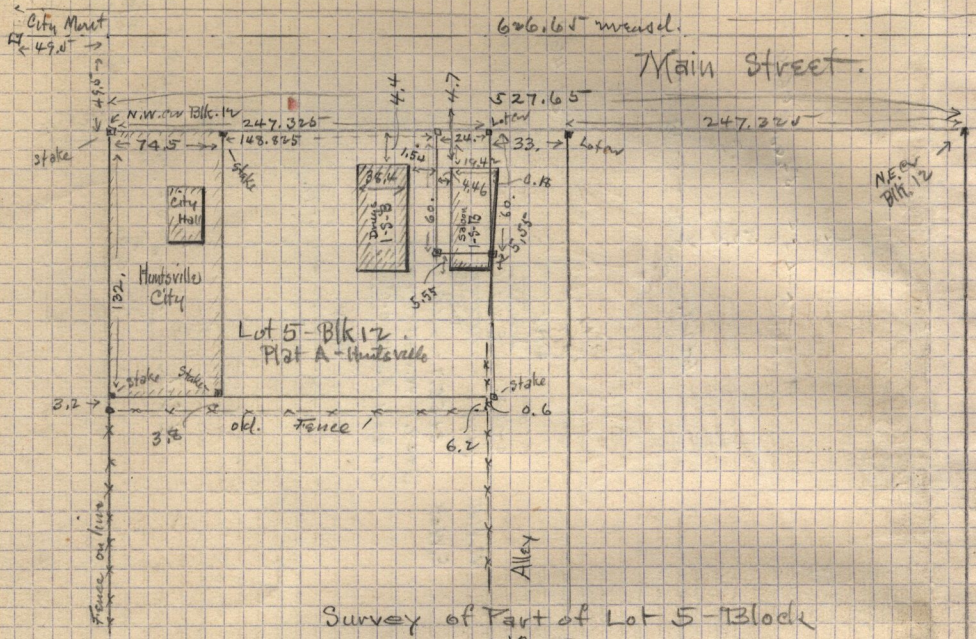

Survey of Part of Lot 5 - Block 12 - Plat A Huntsville Survey

(For deeds see page 68 this book)