


Sept 17th 1906.
 Survey for Martin Clary - continued from page 65, this book.

M.A. Harrold &

chambers

I commence at Nail described on page 65. and with bearing objects previously described

- ① 0 346.2 feet & set nail. 14° 30' Right
- ② 0 200.0 ft. Thence I run N 73° 00' W
Left 53° 30'
- ③ 0 46.35 & set nail Thence I run S 53° 30' W
Left 29° 45'
- ④ 0 280.1 Thence S 23° 45' W
44.1 N, Side bridge
108.1 S " "
Left 33° 35' Right ✓
- ⑤ 0 400.0 ft. Set nail Thence S 57° 20' W.
Left 18° 20' ✓
- ⑥ 0 556.4 Thence S 39° 00' W
set nail
Left 21° 00' ✓
- ⑦ 0 263.4 Thence S 18° 00' W
set nail
Left 61° 00' Right.
- ⑧ 0 347.5 Thence S 79° 00' W
set nail
Left 15° 00' ✓
- ⑨ 0 251.0 Thence S 64° 00' W ✓
set nail
Left 34° 00' Right ✓
- ⑩ 0 294.6 Thence N 82° 00' W ✓
Left 29° 54' ✓
- ⑪ 0 700.0 Thence S 68° 06' W ✓
Left 28° 06' ✓
- ⑫ 0 308.1 Thence S 40° 00' W. ✓
to nail
Left 6° 20' Right. ✓
- ⑬ 0 1000.0 Thence S 46° 20' W ✓
set nail near S.L.M. on S. Side Open
River

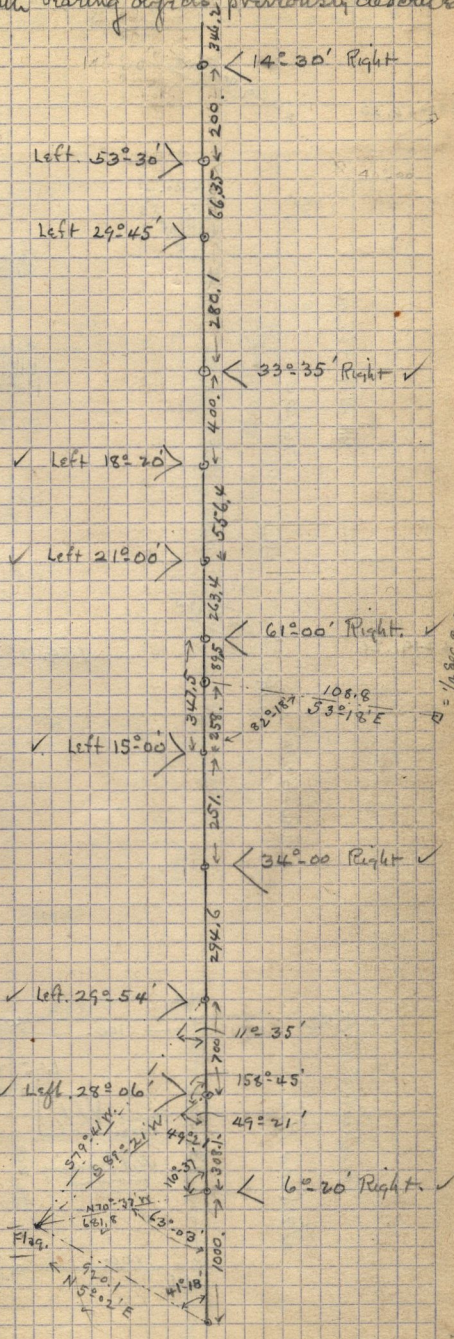

D = 1/4 sec.
 bet. 154.19. (Stone.)
 T.B.N. - P. 1. E.