

Sept. 19 - 1906

Copy of description deed of Will Browning

Survey made Sep 21

Self, Harrop & Stone

176

Pl. Lot 6 - Blk. 39 - Plat C. Ogden City Survey.

Beg. N.W. Cor. and Lot. E 100. ft. S 132.0 ft. W 100. ft. N 132. ft. to Beg.

Sta. 130+52.30

City MT 1204

City MT 112
23rd Street

Blk. dist 762.04

761.04

Ave

Van Buren Ave.

38 C

122491.26

City MT 125


759.0

City MT 109

23rd Street

146+02.20
Jackson Ave.

153+61.22

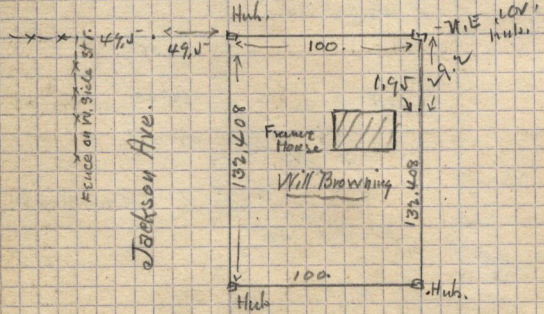

FEENCE ON N. SIDE ST.

Jackson Ave.

Frame House

Will Browning

W.E. 100' Huh.

Huh.

Huh.