


GRANT AVE.

764.94 Ft. Centers.

Block Dist. = 665.94 ft. Each Lot = 133.188

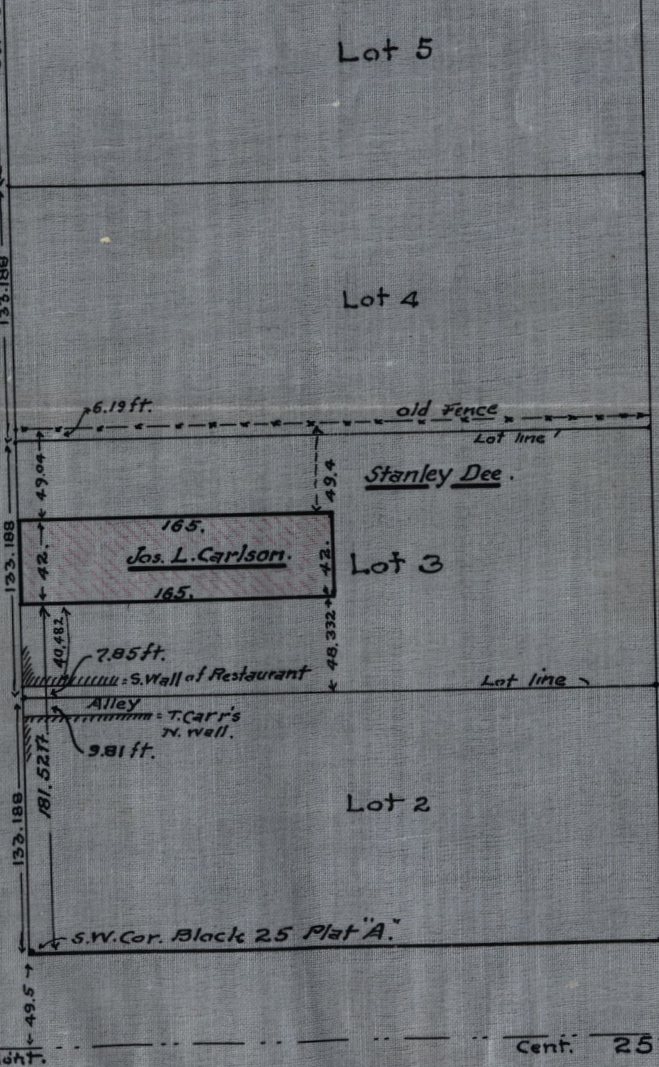

Lot 5

Lot 4

Lot 3

Lot 2

165.
Jos. L. Carlson.
165.

Stanley Dee

old fence
Lot line

Lot line

s.w. Cor. Block 25 Plat "A."

Cent. 25th Street.

Plat of land to be conveyed by
Stanley Dee to
Jos. L. Carlson in Lot 3
Block 25 - Plat A. Ogden City
Survey.

Surveyed by Washington Jenkins. (E.)
according to Ogden City Survey Monuments.

Scale 100' = 1 inch. Nov. 10th 1906.