April 22nd 1907 –

Survey of Lots 5-6-7-14 Blk. 4. Monterey Add. for Fred Redfield

W. A. Harrop and Hy Stowe assist

See official Plat of Monterey Add. on page 82 – this Book.

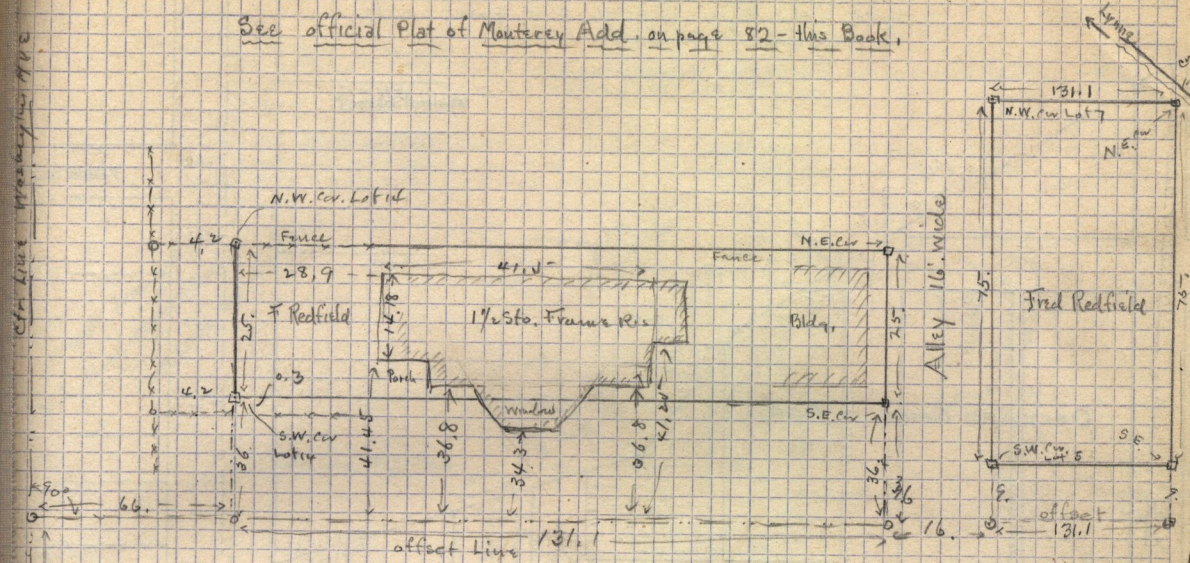

May 16-07

Re-survey for Martin Clary in Oyster Canon
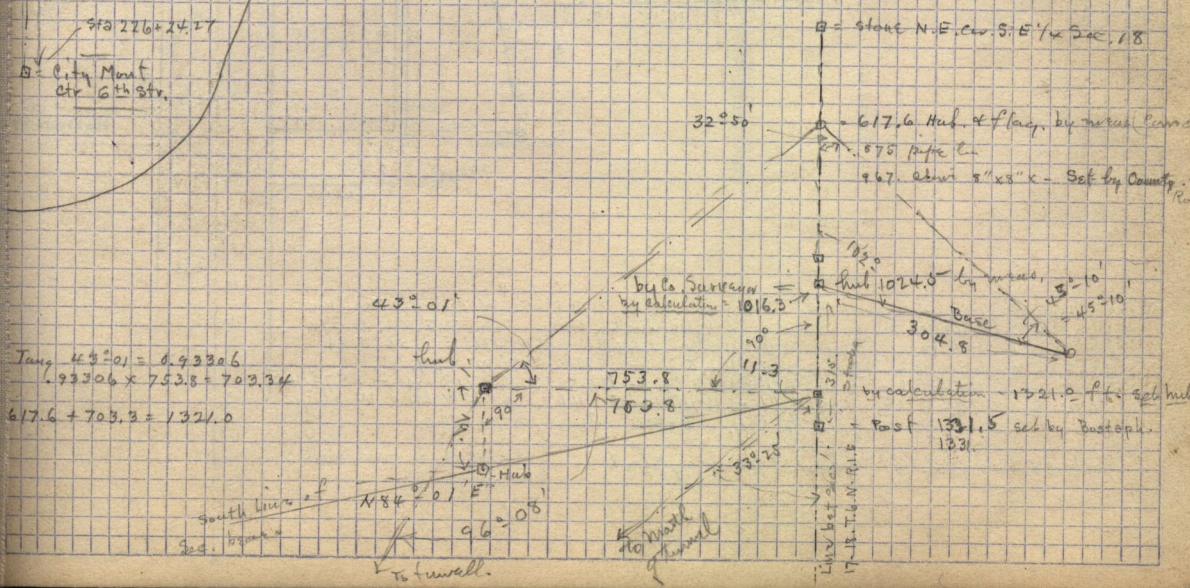
3 set ¼ from Org at N.E. cor S.E. ¼ Sec 18. T. 6 N. R. 1 E. & Mrgs. South with Tops