

June 9-1907

44 - 220 deede

Central Investment Co. to Annie Wahlberg.

Part of Lot 1 - Blk. 44 - plat A Ogden City Survey - Beg. at point 8 Reels W. of S.E. cor
said Lot 1 - W. 58.86 ft. - N. 132 ft. E. 58.86 ft. S. 132 ft. to Beg.

95


* He is in Court and the following description furnished by Craman is what he is
suing for - Beg. 181.5 ft. W. along cty 23rd St. and 49.5 ft. N. from Ogden
City Survey Meridian at cty 23rd & Jefferson Ave. - Thence W. 0.5 ft. N. 132 ft.
E. 2.25 ft. S. 132 ft. W. 1.75 ft. to Beg.

He wants the survey verified

Ave

Ave

ft

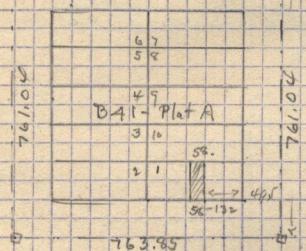


23rd St.


Adams

ft

old fence
2.25 ft

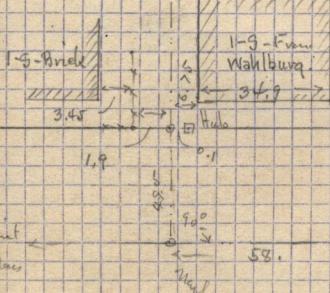

to City Limit
23rd & Adams

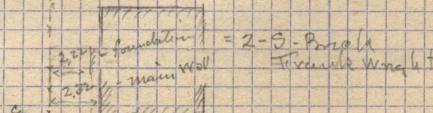

= 2-3 - Parcels
Evans Wahlberg

S.E. Cor. Lot
1 ft 49.5 ft

132.

cty. 23rd St.

181.5

cf. affidavit