Oct 6-1907

Survey made for Dr H.B. Forbes -

description - N½ Lot 4 - B. 47 - Plat A. Ogden City Survey -

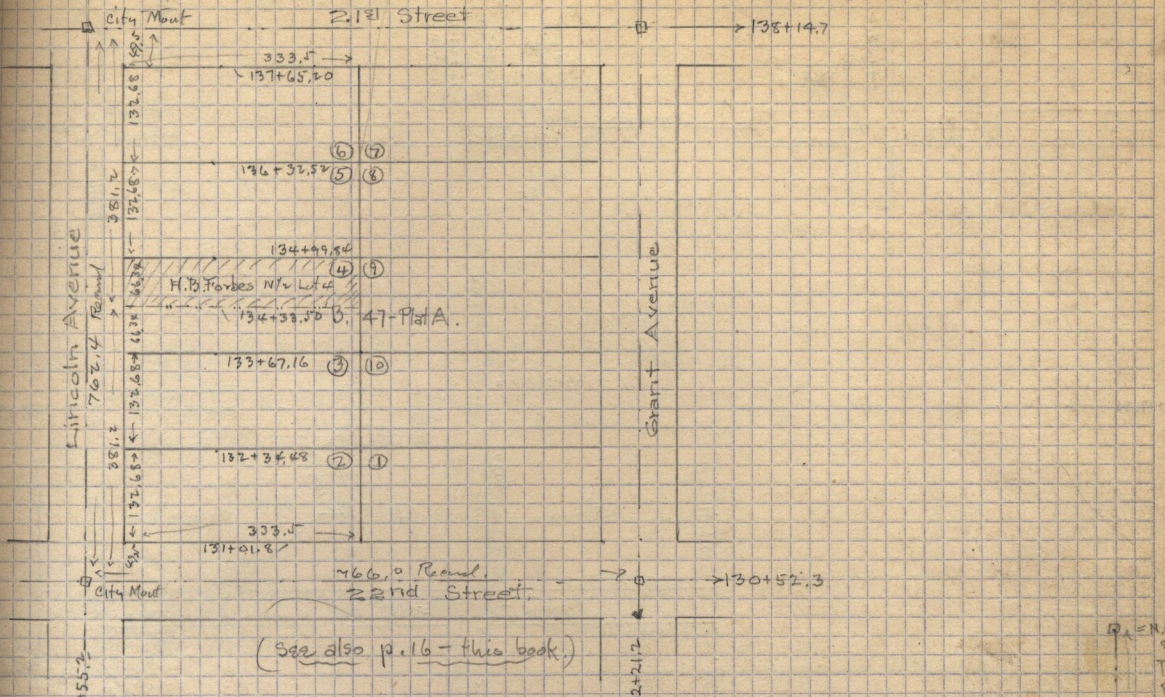

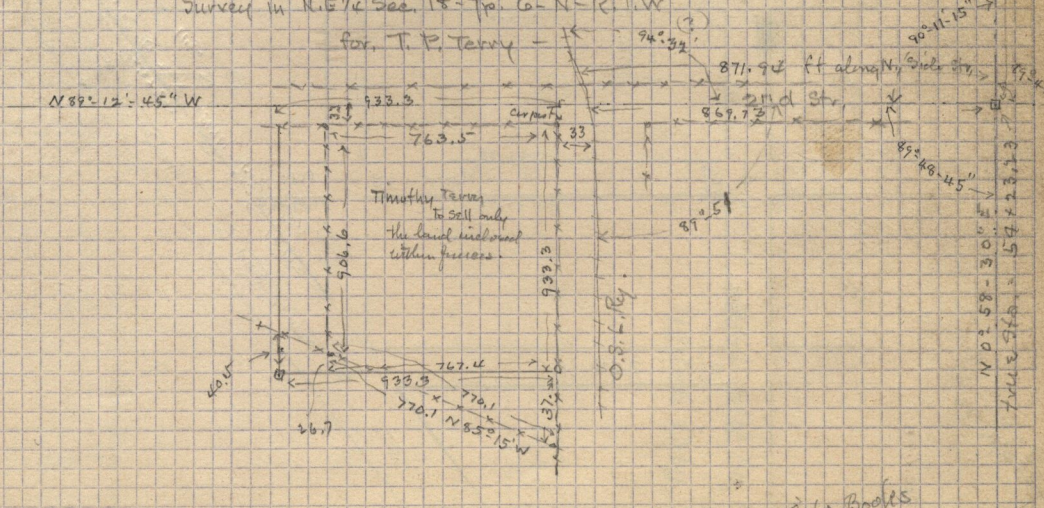

(See pages 64-66-91 116-117)