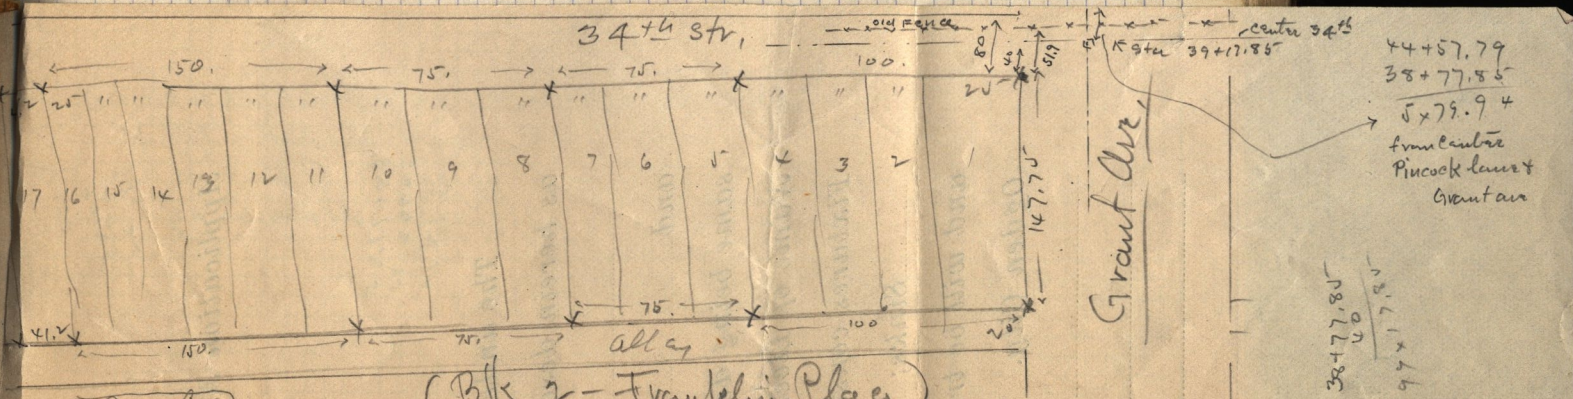

Survey for
Geo. Dawson

(Blk. 2 – Franklin Place)

(Geo. Dawson)

to be done Sunday, June 13 — 1909