


Continuation of Lehighville Cemetery Survey
 (also pages - 68-69)

(9)	(8)	(7)	(6)	(5) Maryann Mauson P. Mauson
(12) Nathana Slater	(13) Wm Lyndy	Fraser Jewel Reed F. Jackson (14) Milton W Ritterick	Caroline Addison (15)	Elizabeth L. Johnson Kangland (16) R.D. Sprague B.D.J.
(19) A.M. Ericksen	Sarah J. Anderson 28 (9)	Fraser Peter S. Willard et al (27) Jens Nielsen	(26) Afrod Bodum	Larsen Vacant (25) Clas Grove Eiza Eugstrom

Main Street in Lehighville Cemetery

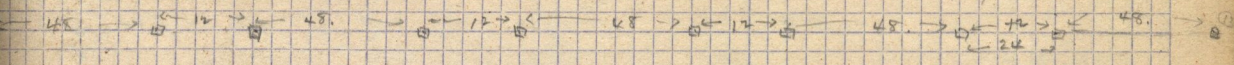

Ap. Kestran (32) F.M. Paulsen	Soren Peterson (33) P. Moxness Nelson	P.C. Rasmussen J.P. Gravel (34) Christina Lundvall A.P. Johnson	Maria Wanggaard (35) C. Wanggaard Wanggaard	Hammond (36) Christian Jensen
Annice E. Thurston (49) May Bingham	Fulin Allen (48) Marj Allen	Robert Aldous (47) Rasmussen	Dorthea Knudsen (46) John T. Hilopi	John A. Smith (45) Peter Johansen
(52)	(53) Andrew H. Anderson	Christina Hansen (54)	Margues Johansen (55)	(56)