



Notes of Street center 24th St. from Tyler to City limits
(Oct. 1927, Switz)


Sketch 1

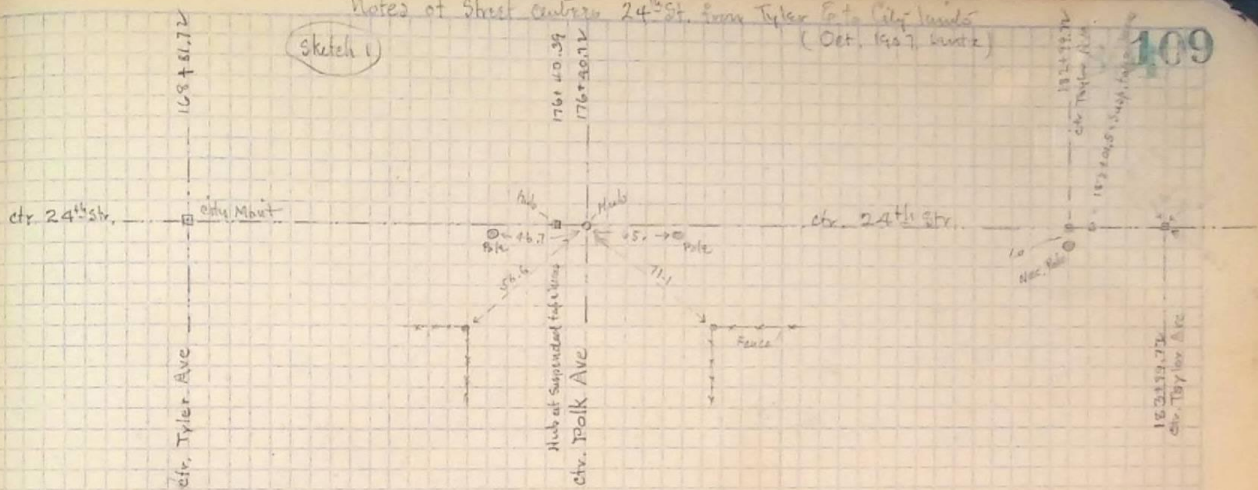

Sketch 2

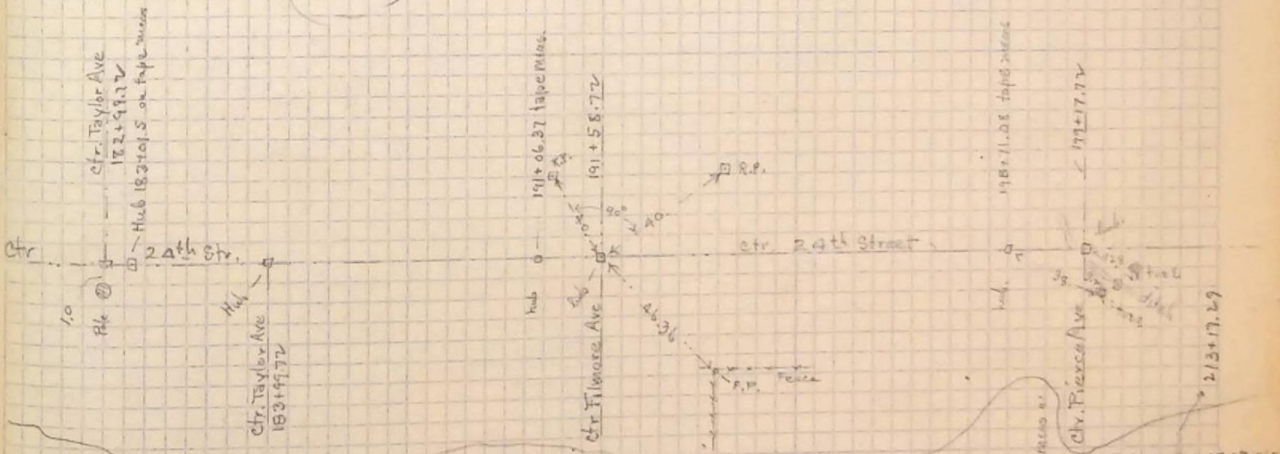

Sketch 3

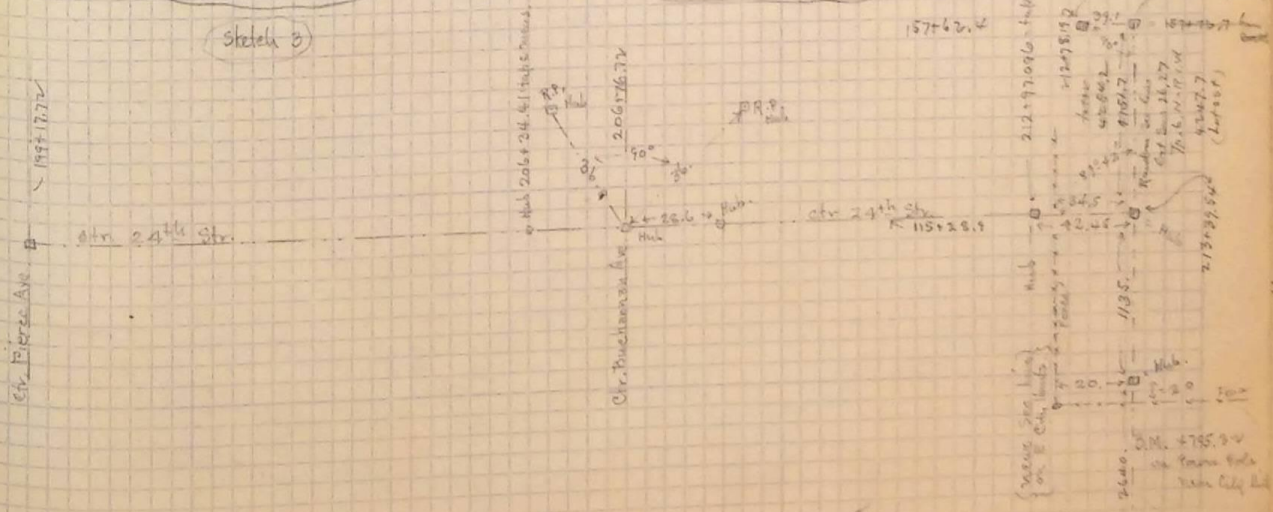

(See also p. 111)