



110

24<sup>th</sup>

115+28.9

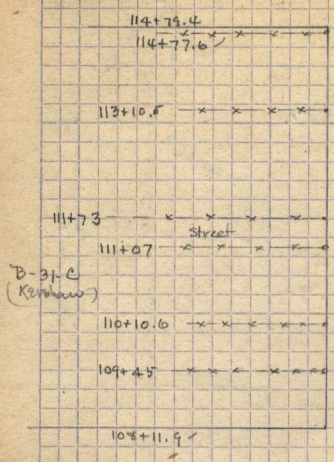


B-31-C  
(Kerchaw)

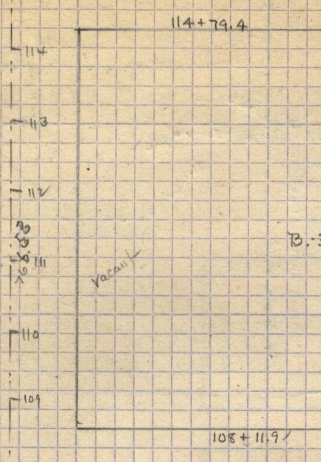


B-30-C = Capitol Bldg. Sub.

25<sup>th</sup>

107+62.4

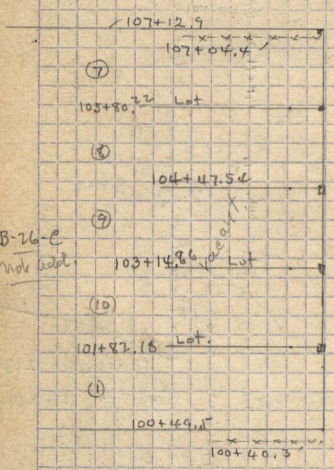

B-26-C  
not used

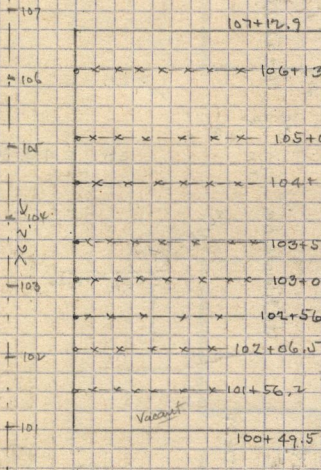

(B-27-C)  
(Coreys Sub.)  
W 7/2 B-27

Brinker &  
Hoekstede

26<sup>th</sup>

100+00

Van Buren