
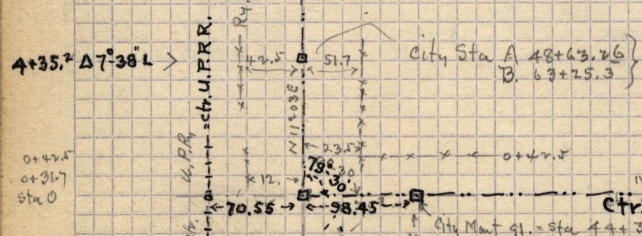
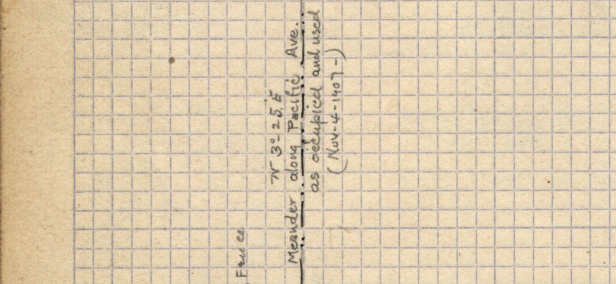
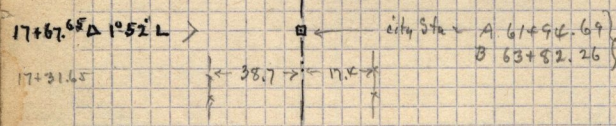
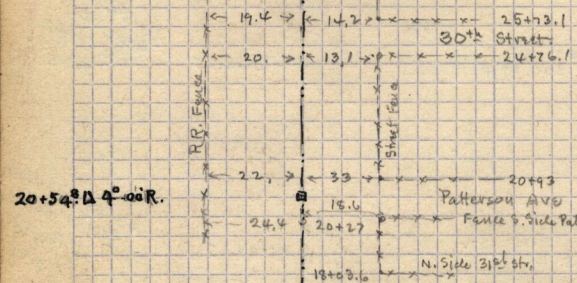


4482.2  $\Delta 74^\circ 54' R.$   
112

28<sup>th</sup> Street = 28<sup>th</sup>  
912.6 B

Mont. land  
→ Mant Ctr. Wall

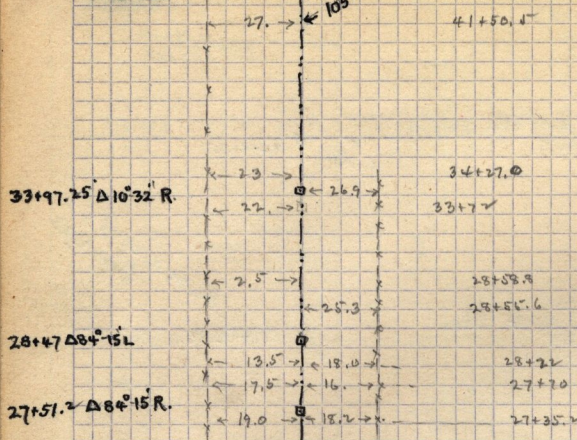

N 69° 27' W  
Ctr. Pincock Lane