March 29-1908

Survey for --- Leavitt of land in N.E ¼ Sec. 17-Tp. 6-N-R. 1. W

Description furnished by Leavitt - Pt. N.E ¼ Sec. 17-Tp. 6-N-R. 1. W. Beg. 179.52 ft North & 247.5 ft E. of S.W. Cor. of ¼ Sec, Running thence E 193.3 ft - Thence N 1°-23' E 1013. ft. more or less to ctr. of Street - Thence West 66. ft, - thence S 1°-23' W 682.75 ft - Thence West to a point N 1°-23' E of Beg. - Thence S 1°-23' W 330.75 ft more or less to Beg.
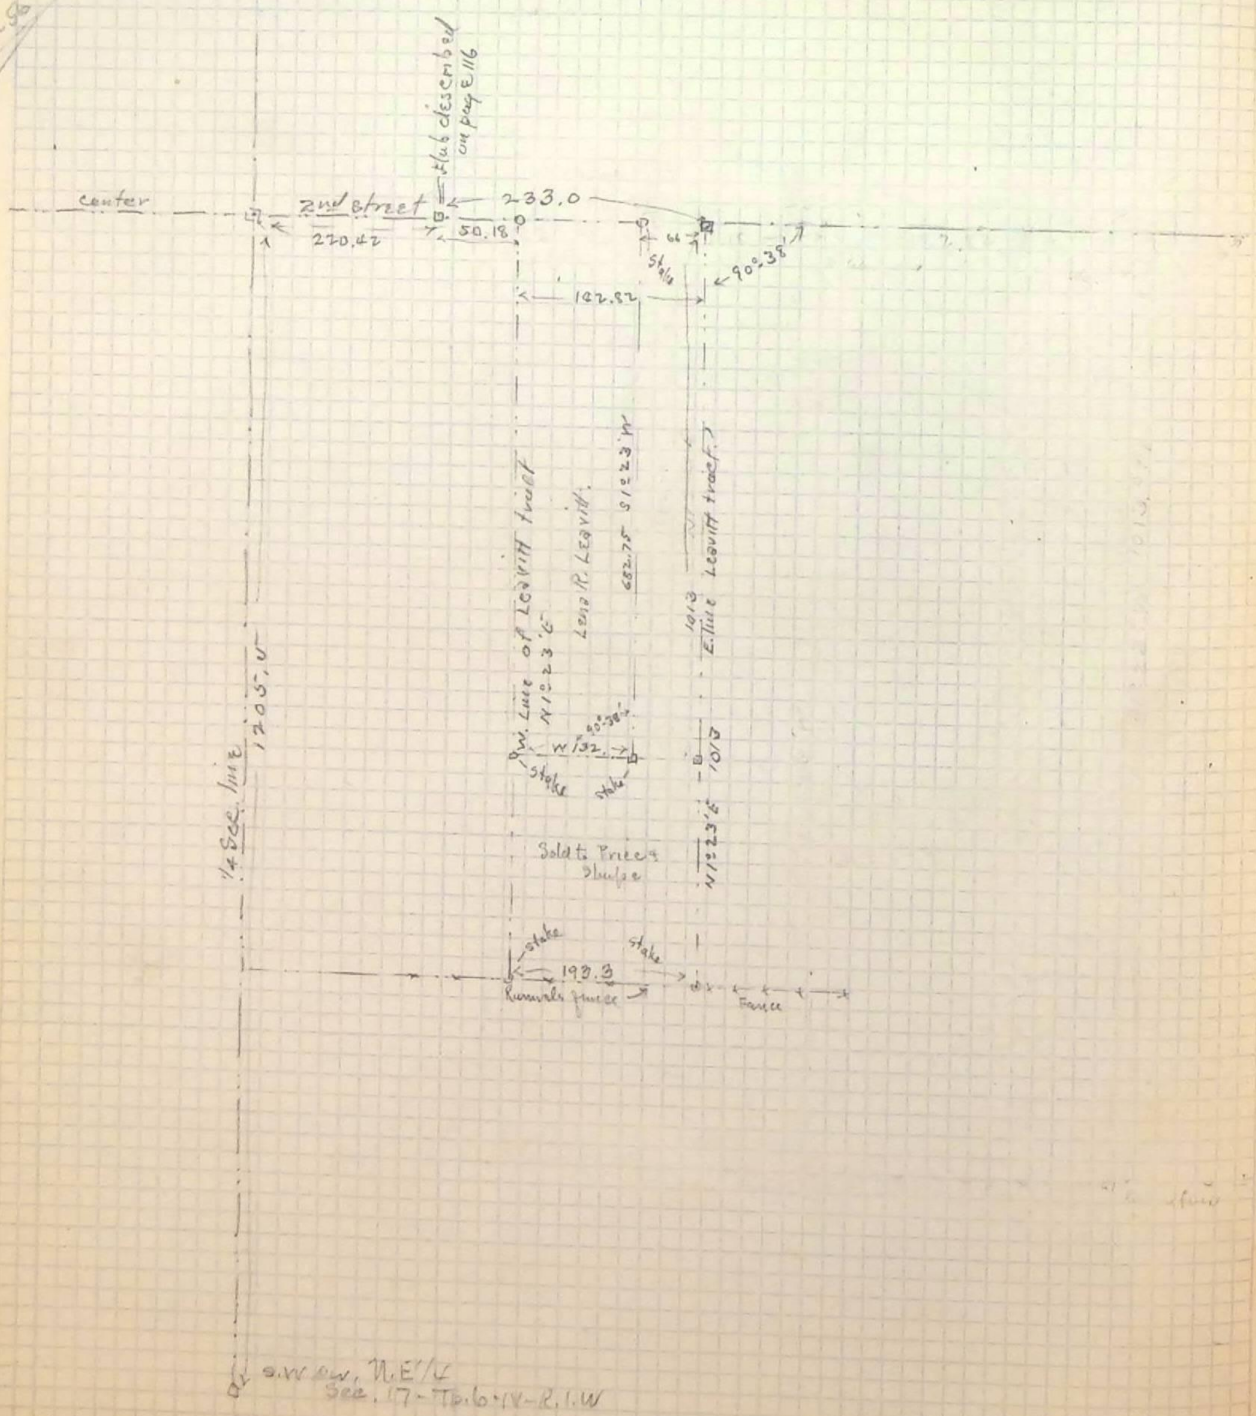
See field Book 2-56