April 4th 1908 -

Survey for
to A.J. Marshall.
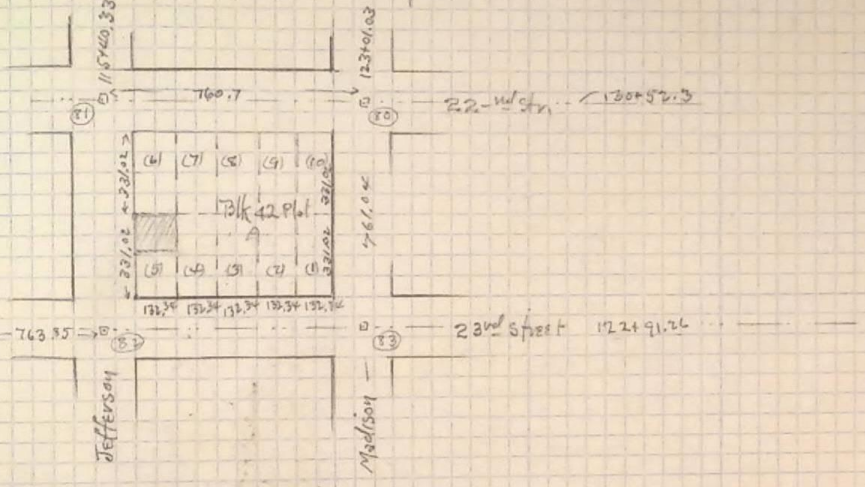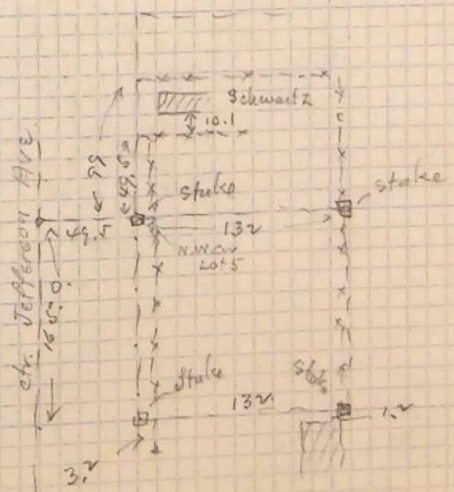
Copy of deed - Rosina Marshall — Park of Lot 5 - Blk - 42 - Plat A. Ogden City Survey
Beg. at N.W. cor. of Lot 5 - Run thence E 5 rods - thence S 10. rods - thence West 8 Rods - N. 10 rds. to beg