May 26-1908

Survey of Lots 23-24-25-26
Blk. 6- Rushton Add
for Sidney Baker
Harris & Stowe audit
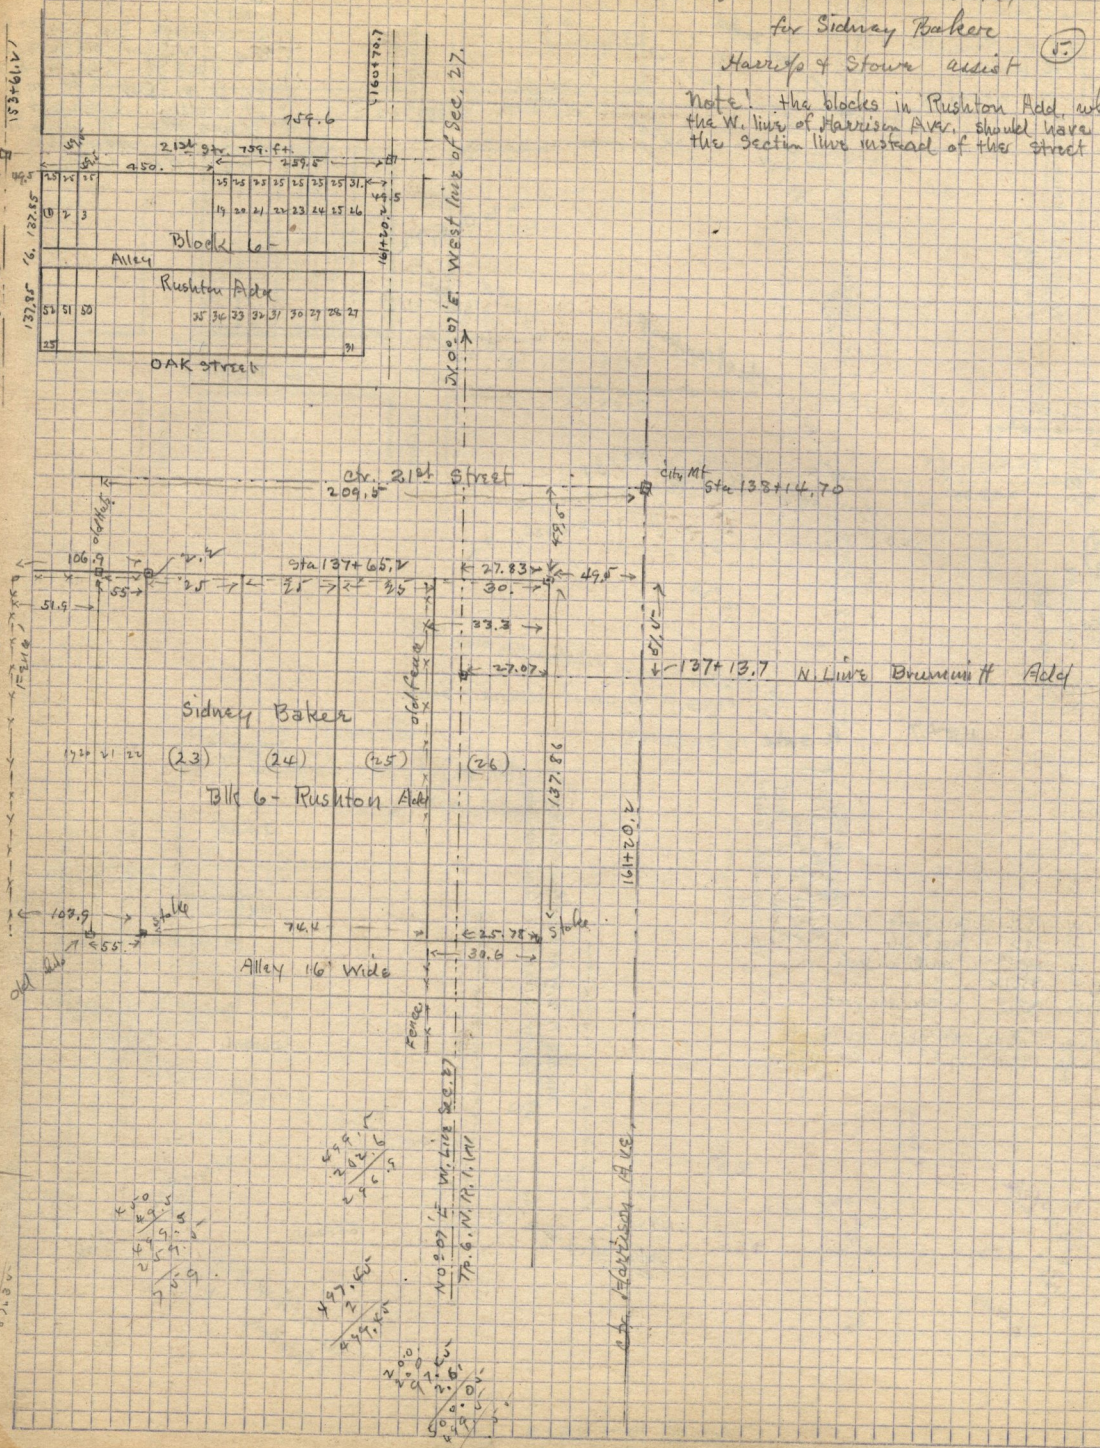
Note! the blocks in Rushton Add. which adjoin the W. line of Harrison Ave. should have formed on the Section line instead of the street line.