


See also page
116-117

July 17-1908
Survey for B.F. Pierce in N.W. 1/4 Sec. 17-75 - N-R.I.W.
John Stoddard Assist.

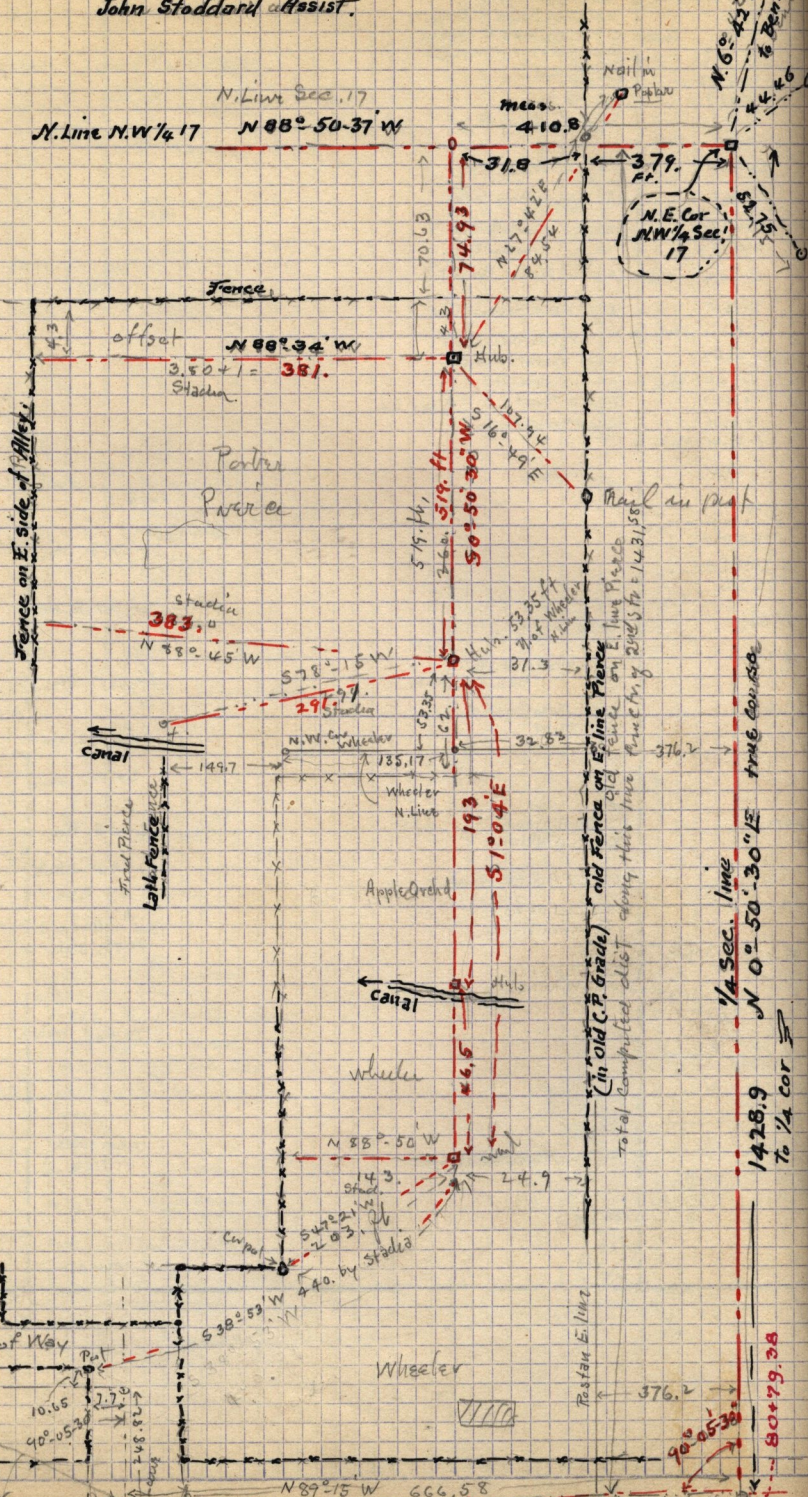

See page 117

2nd Street