Survey for G.W. Braunwell.
Tom + W.A. Harrold asst.

G.W. Braunwell description beg
10. rods S. of N.E. cor. Lot 10 - Blk 4
Plat B - Thence - W. 16. rods - S. 10. rods
E 16. rods - N 10. rods to beg.
Reserving 30. ft. alley on W. end
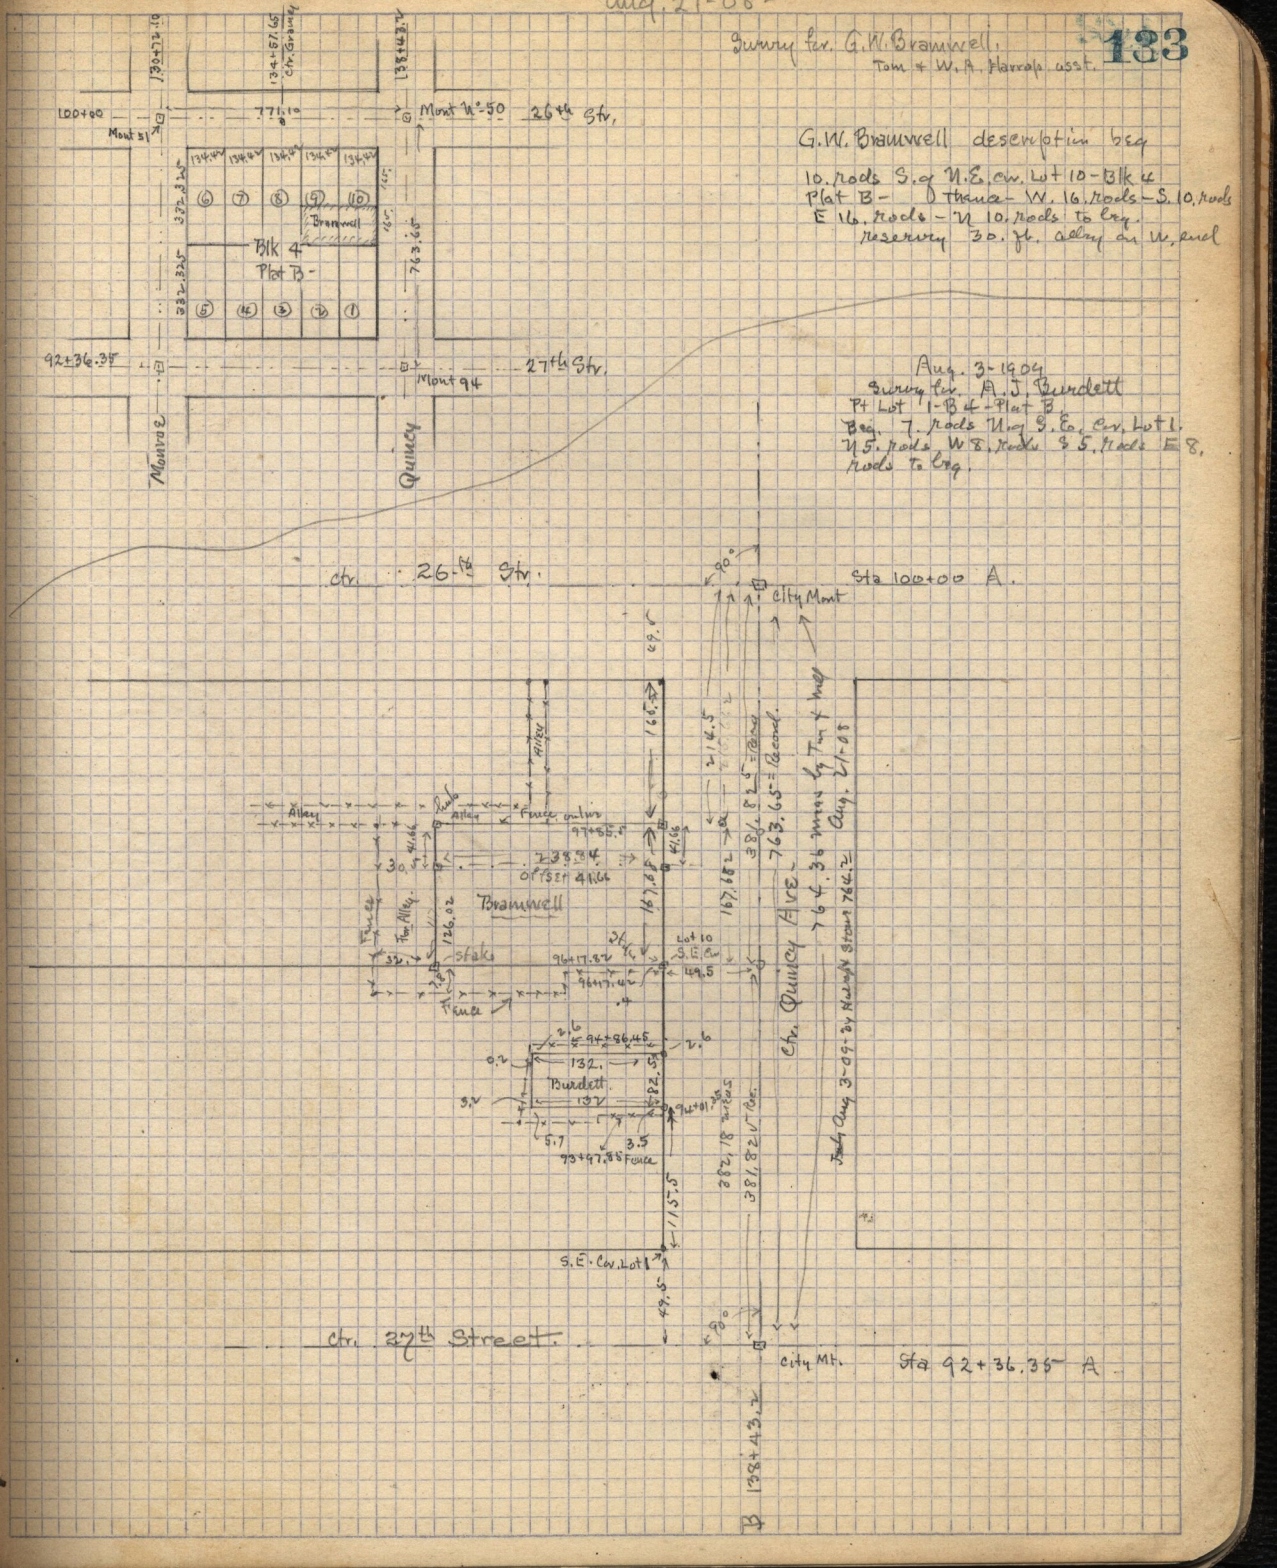
Aug. 3-1904
Survey for A.J. Burdett
Pt Lot 1 - Blk 4 - Plat B
Beg. 7. rods Nly S.E. cor. Lot 1.
N 5. rods W 8. rods S 5. rods E 8.
rods to beg.