

April 21-09 - Survey for W.W. Brown
lots 47-48-49-50-51-52 in Blk
22 - Lake View - Acd

34+06.93 = Co. Mont No. 4's

267.08

31+47.85

cty. 35th Street.

Detail of
Fence measured on possession
lines on 6. acres Washington
ave. south of 36th Street.
April 26-09 -
(See also page 135)

36th Street = 24+31.85

Street W 23+98.85

x x x Fence 22+66.75

x x x Fence 22+18.09

x x x Fence 21+26.09

x x x Fence 20+76.09

x x x Fence 20+00.09

x x x Fence 18+99.09

x x x Fence 18+25.09



N. Line Street.

17+48.85

37th Str. 17+34.59

x x x Fence 16+76.79

x 16+82.85 s. line 37th

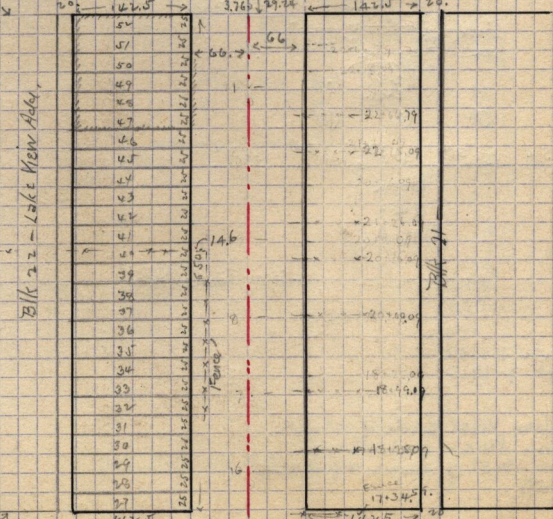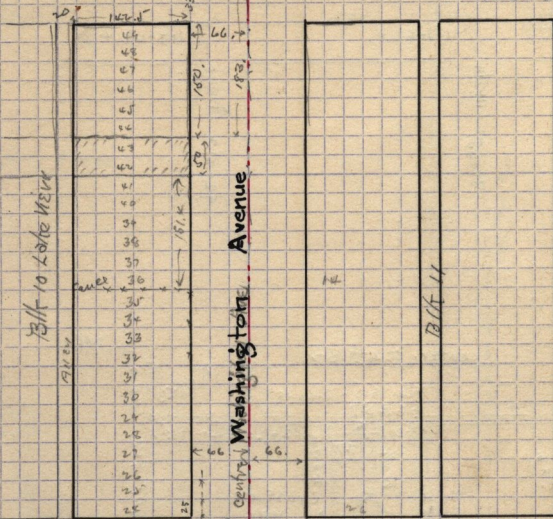

Washington Avenue

Washington Avenue

Ogden Avenue

Ogden Avenue

Blk 10 Lake View

Blk 2 - Lake View Add.

36th Str.

37th Str.

24+31.85

376.79.84

142.5

66

66

