



April 23rd 1909.

Survey of Lots 15-16-17-18 Block 5 - Central Park Addition for R. D. Robins

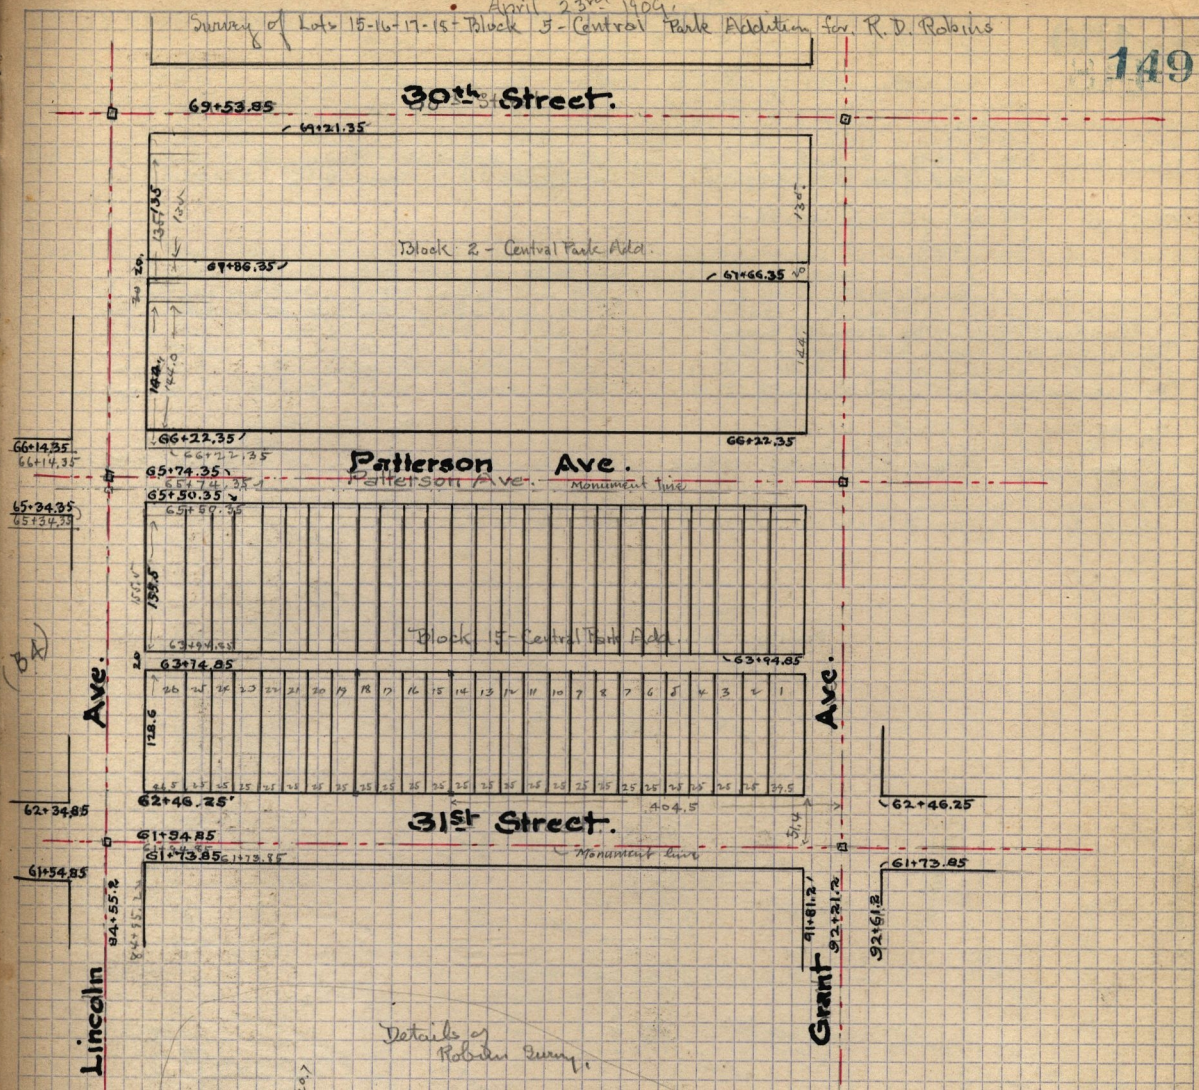

Details of Robins Survey.

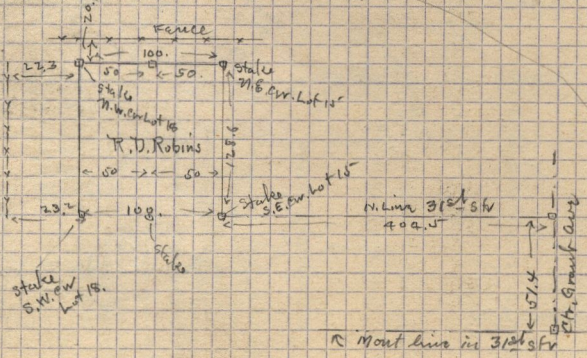

N. Line in 31st St 400.0