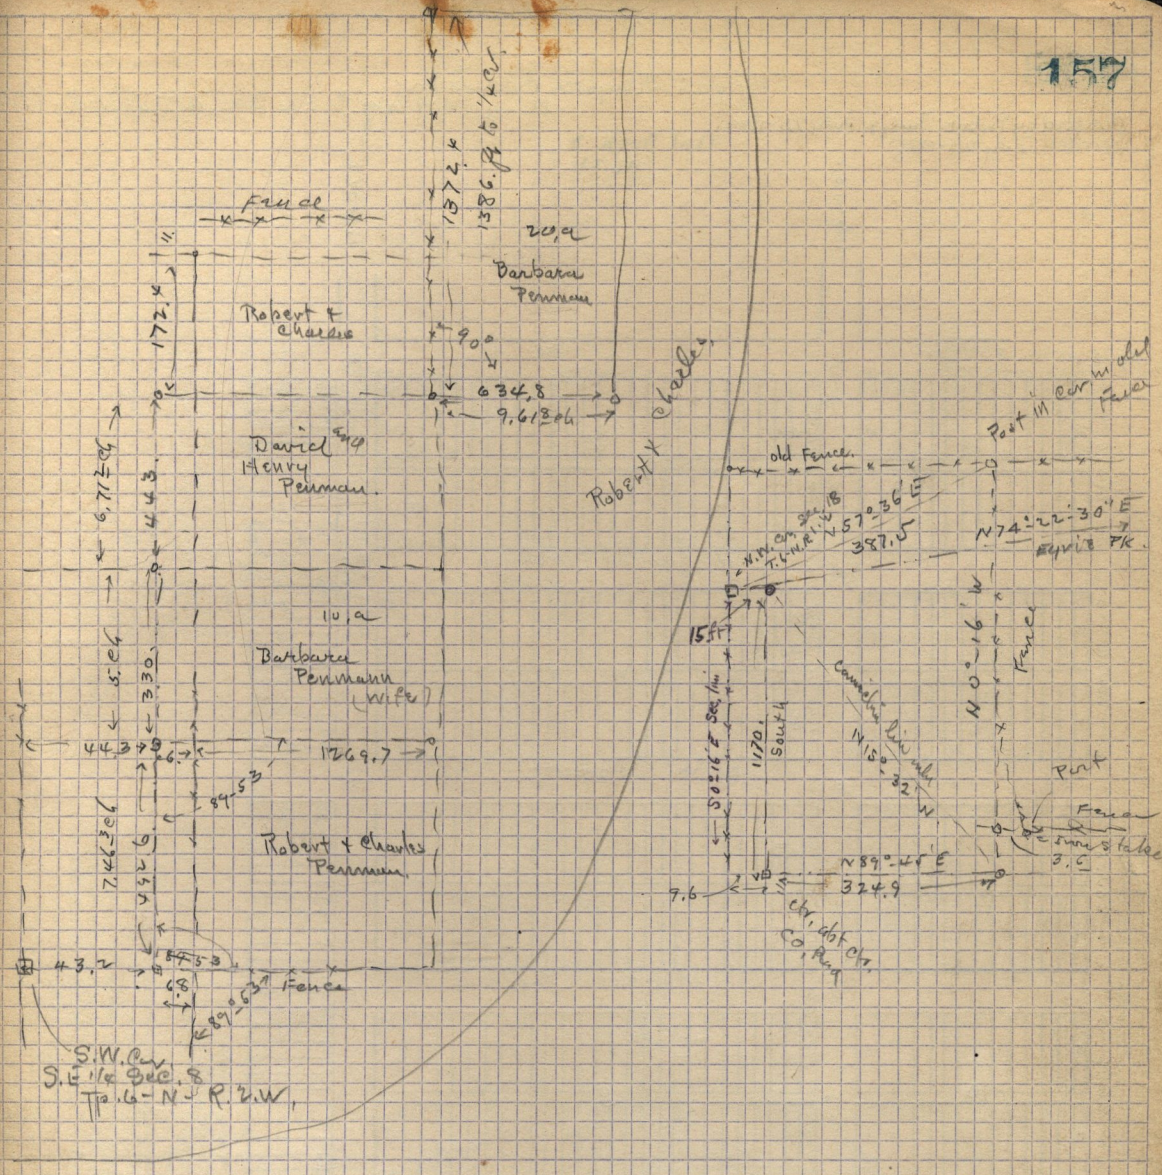

46-41 – Adolph Layman & wife – Wm Layman & wife & Nettie Layman Dudman – Quit Claim to Conrad Layman. Dated January 16-1904 –
The S.W 1/4 Sec. 7 – and pt N.W 1/4 Sec. 18 – Tp. 6-N – R.1.W – Beg. at N.W. cor. of Sec. 18 Running thence N 209.0 ft – S 89°-45' E 328 ft – thence S 0°-16' E 1370.4 ft to ctr. of Co. Road – West 334.5 ft along ctr. of Co. Road – N 1162.92 ft to beg. Also the triangular piece lying to the West of said described tract. Beg. at N.W. cor. of above described tract – thence West 8.5 ft – thence in a Southerly direction to the S.W. Cor. of above described tract thence North along W. line of above described tract to beg.

Surveyed above Sept 19-1909

Will Harrop assist