Aug 21-1909

158

Prospect Heights Addition

being N.W.¼ of S.E.¼ Sec. 4 T. 5-N-R. 1. W

Accepted by Probate Judge July 25-1889
(Recorded July 26-1889)
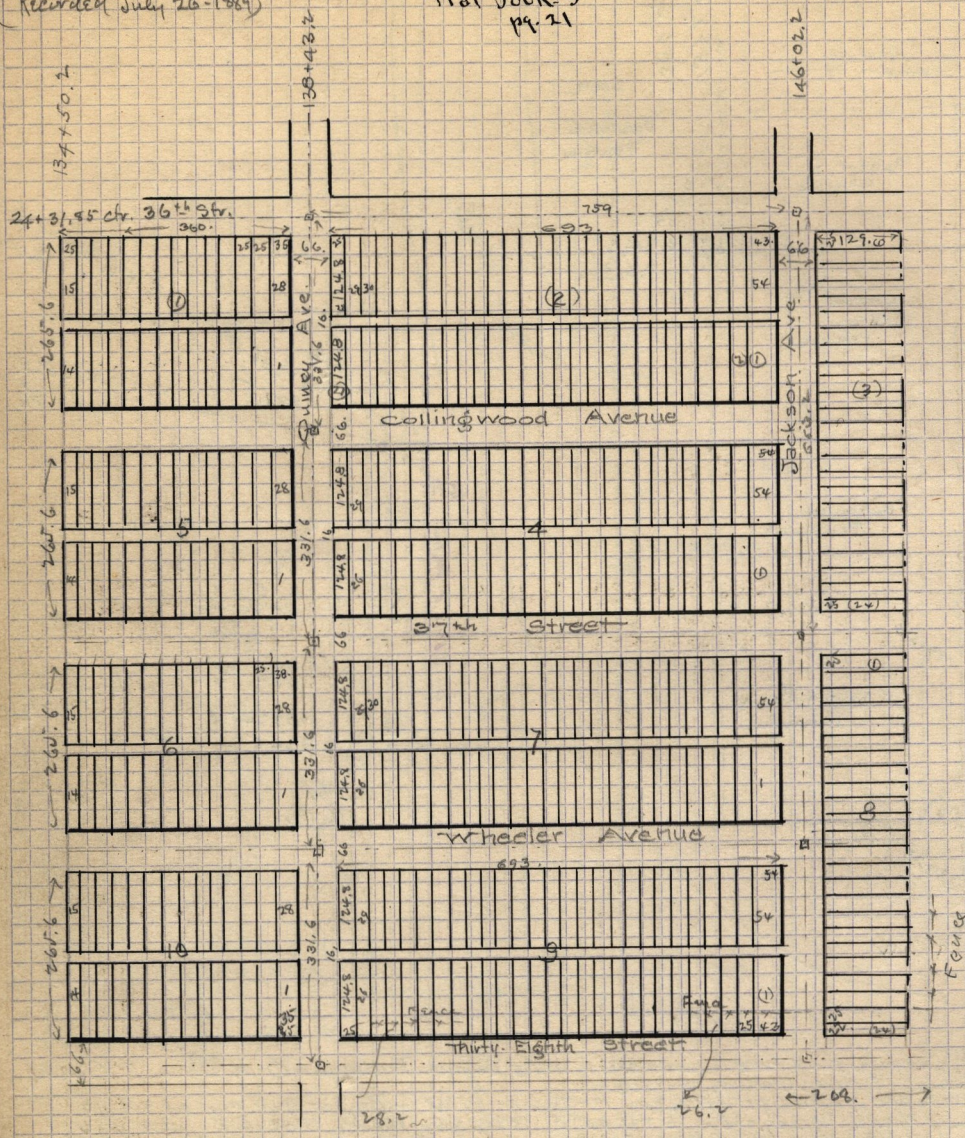
Plat Book 3
pg. 21