Sept 21-1909 - Survey
for Telluride Power Co. through James Taylor &
T.D. Dee land in Sec. 15 Tp. 6-N-R. 1. W
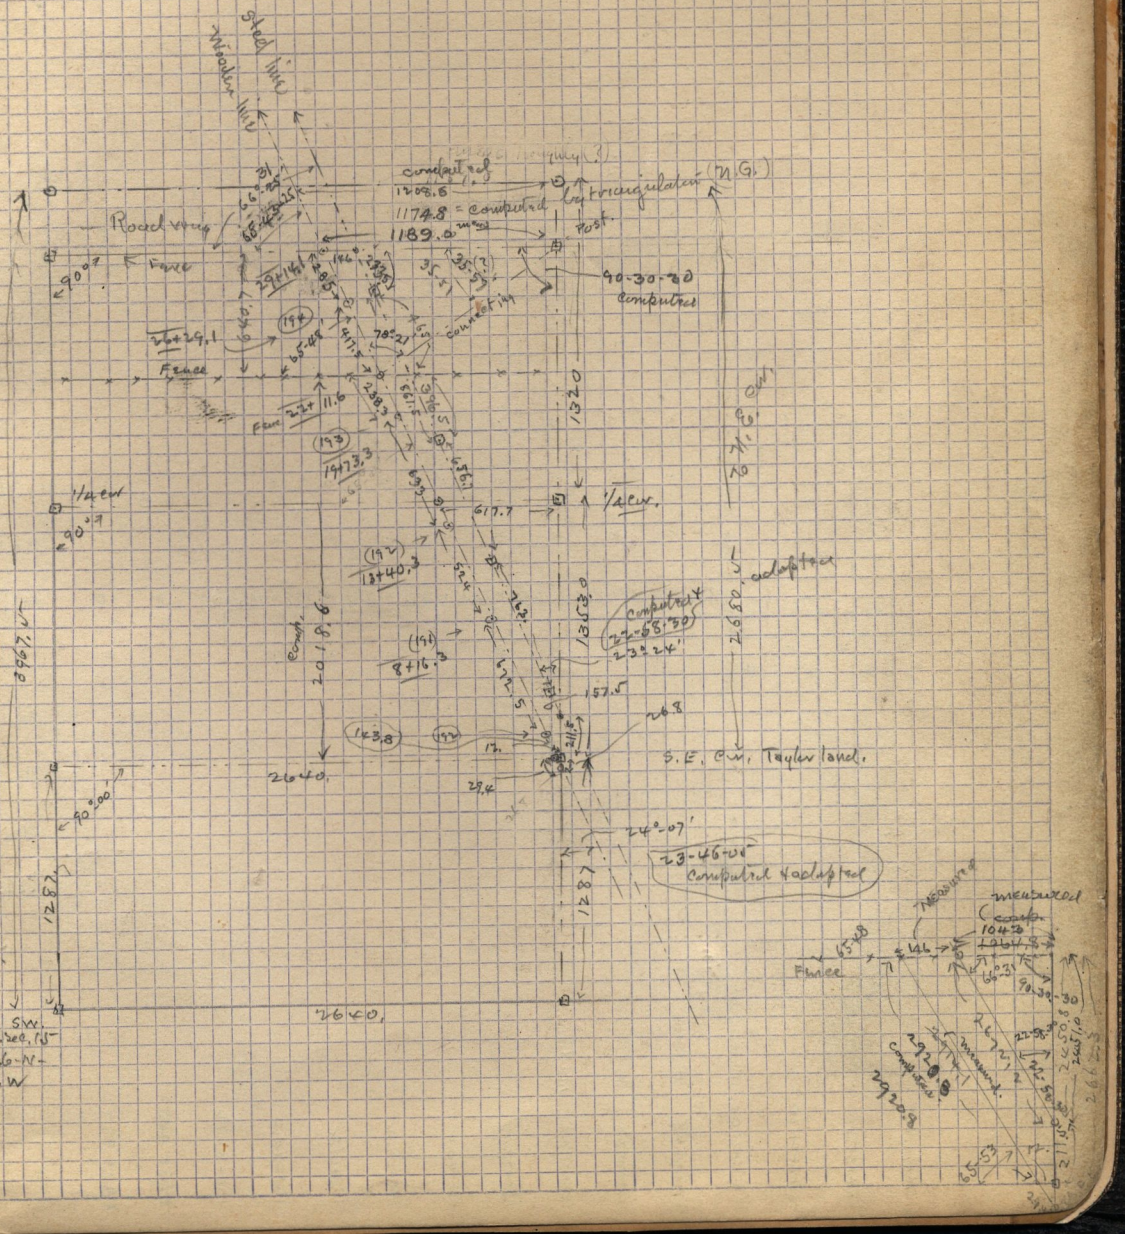
159