(6)

March 30th 1910 -
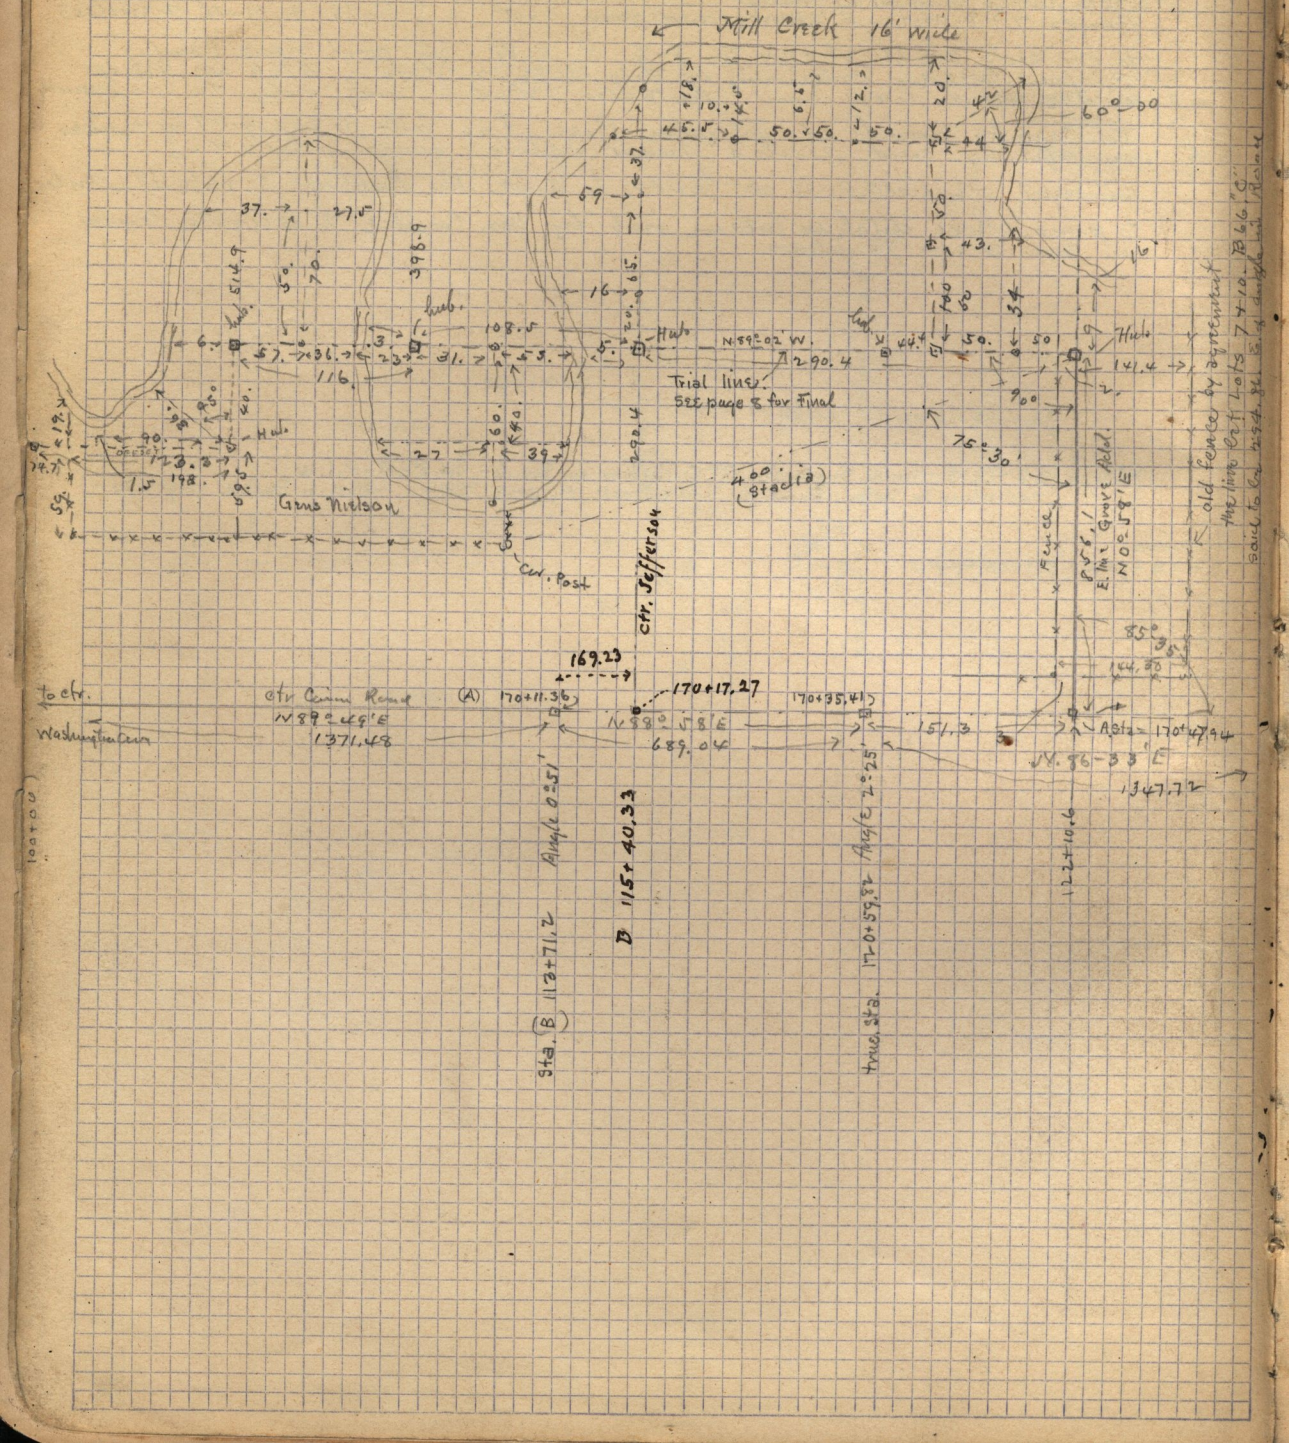
Survey for J. L. Wilson - on T3K 66 - Plat C. to straighten old C.L.