{ See Book D. p. 60 - 145 - 154 -
" " G. p. 21 - 93
" " N. p. 50 -
" " - " 12

Sketch Plat of Sec. 5 Tp. 6 - N - R. 1. W.
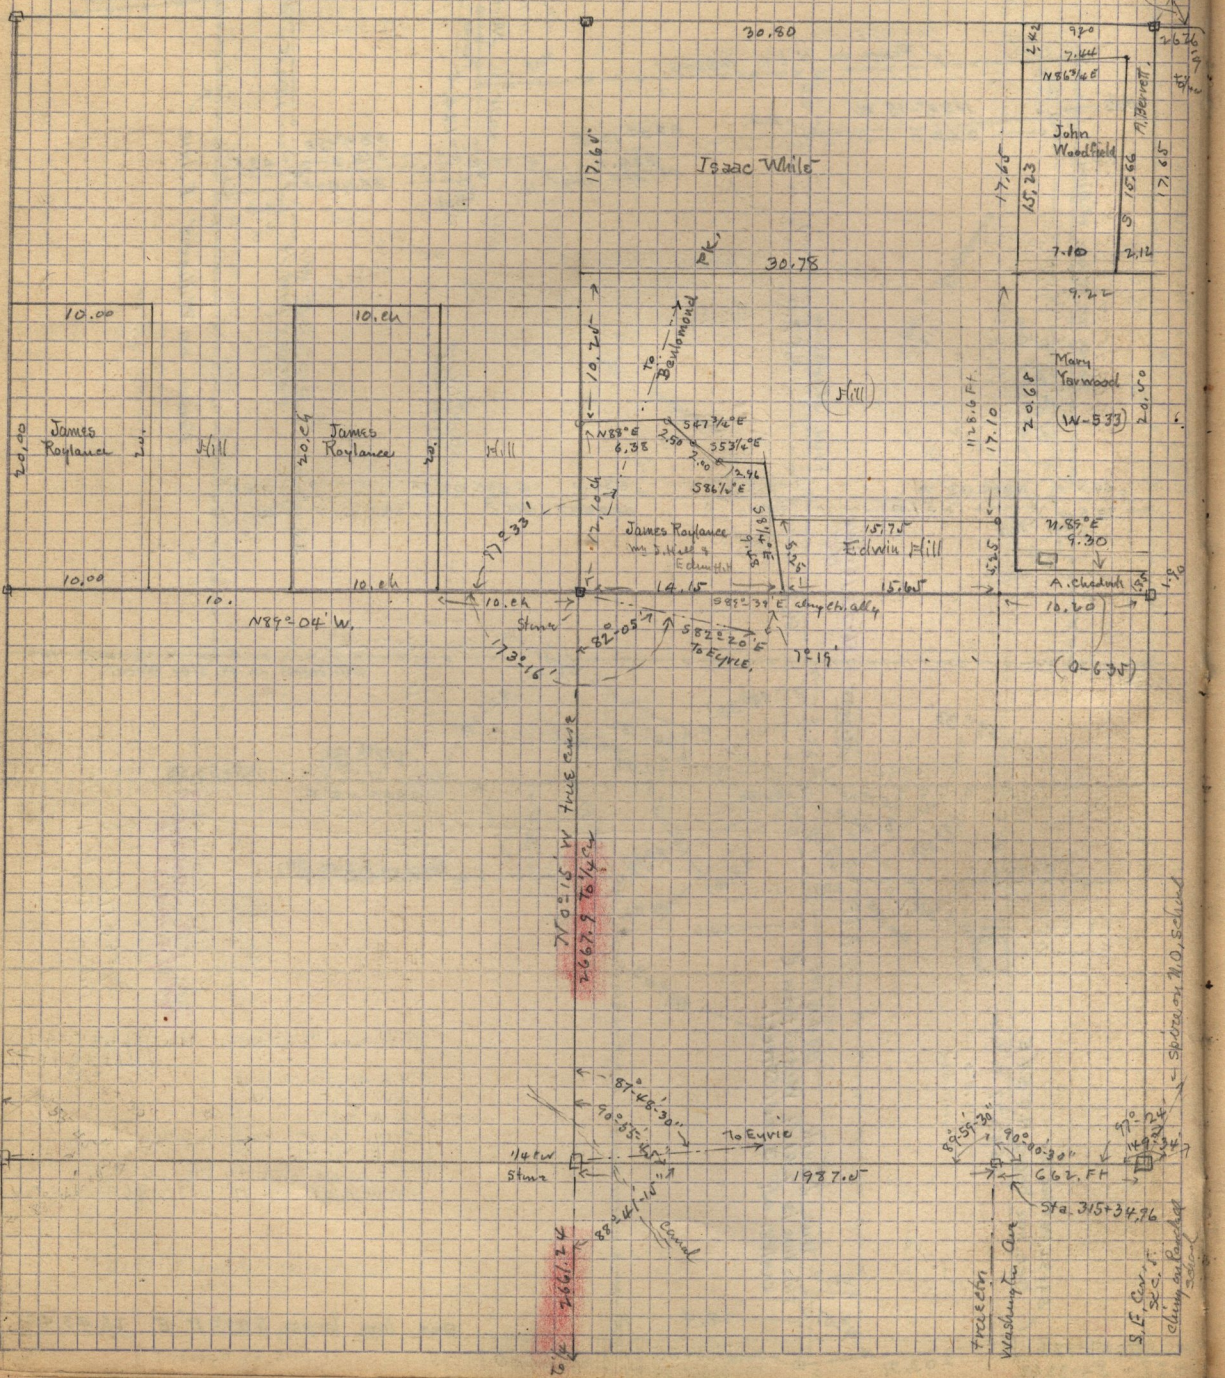
- April 11-1910 -