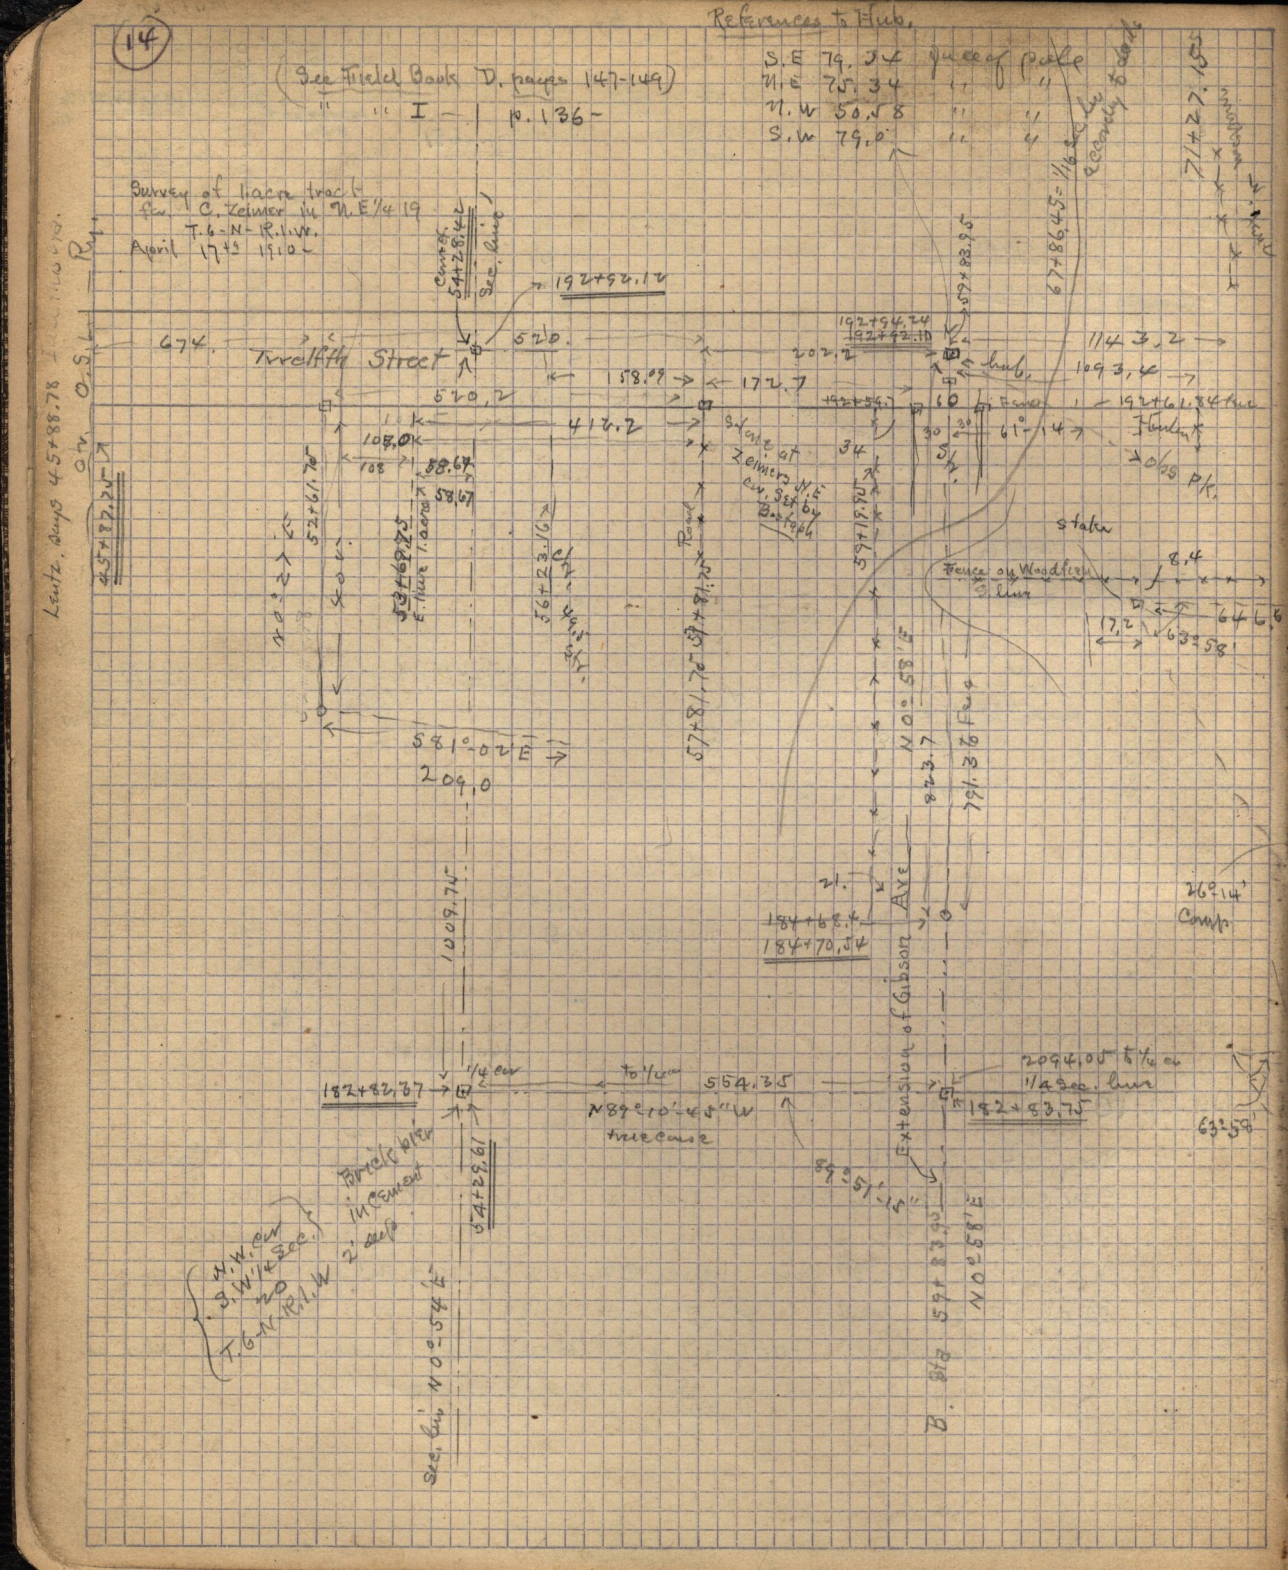
14
See Field Book D. pages 147-149
" " I " p. 136-
References to Hub.
S.E 79.34 ft east of pole
N.E 75.34 " " "
N.W 50.58 " " "
S.W 79.0 " " "
Survey of tiaca tract
for C. Zeimer in N.E 1/4 19
T.6-N-R.1.W.
April 17th 1910
Cement
Sec. Cor.
Twelfth Street
520.
520.2
417.2
172.7
58.09
202.2
Fence
Zeimer W.S.
Fence
Woodfern
Stakes
Fence on
Woodfern
line
Road
Extension of Gibson Ave
N 0° 58' W
2732.8
191.6
Comb
Fence
Fence
Fence