


April 24 - 1919  
 Survey for Hans  
 Jorgensen jr.

(17)

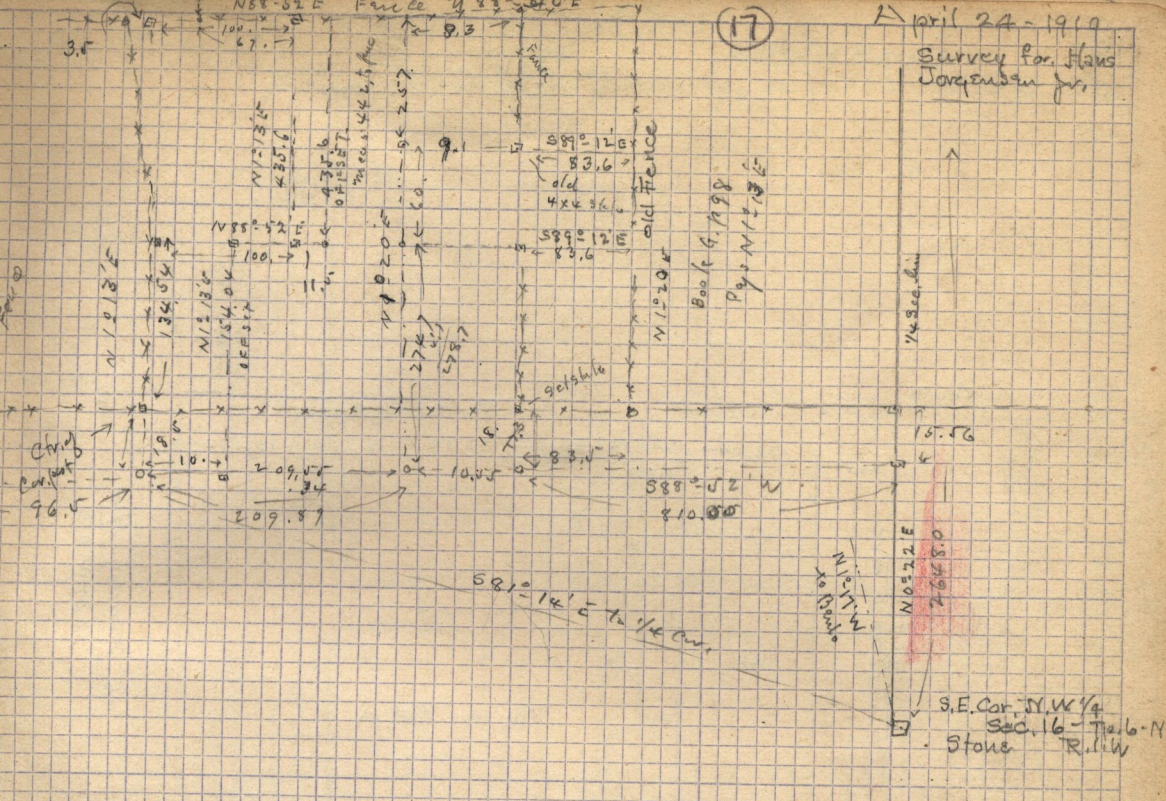


