18

May 1-1910 — Survey for James Pingree

Geo. Watts assist Pickering
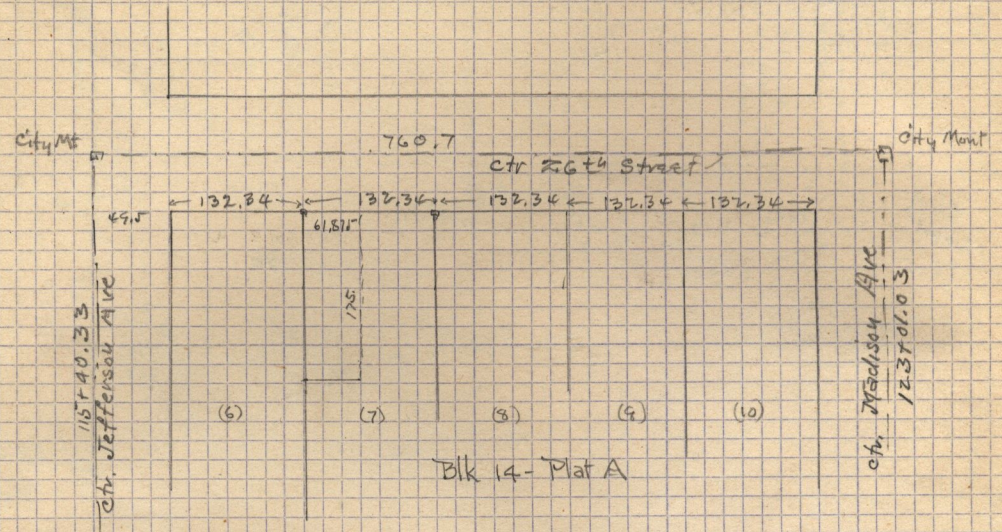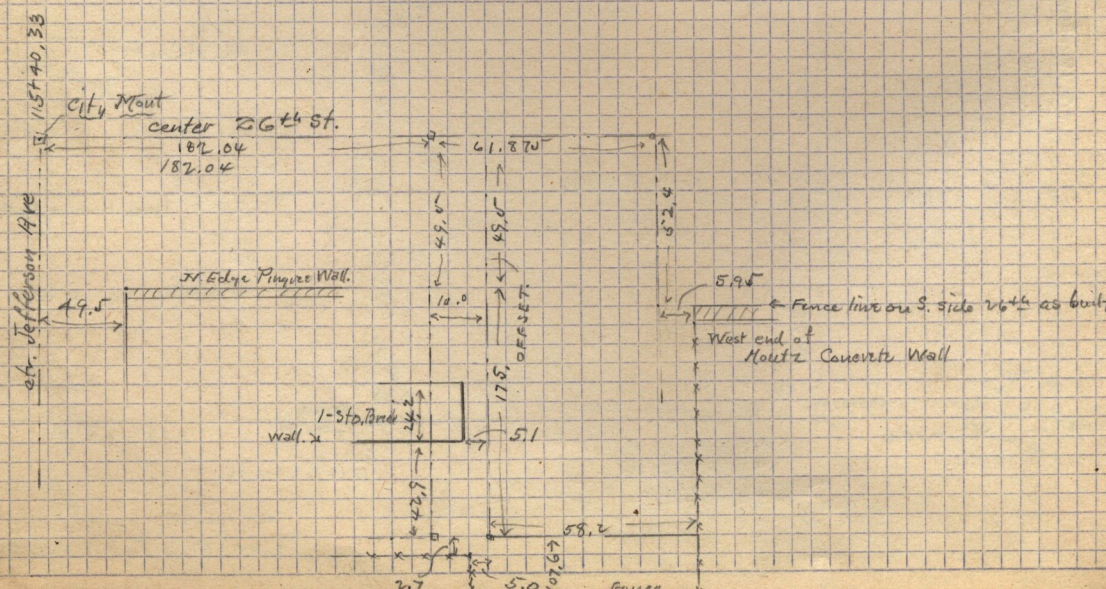
Description - Pt. Lot 7 - Blk 14 - Plat A,
Beg at N.W. cor Lot 7 - Thence S 175. ft. E 33/4 rods
N 175. ft. W 33/4 rods to beg.