Lots 36-37-38-39-40-41

Block 3- East Park Add.

Geo. Rainey
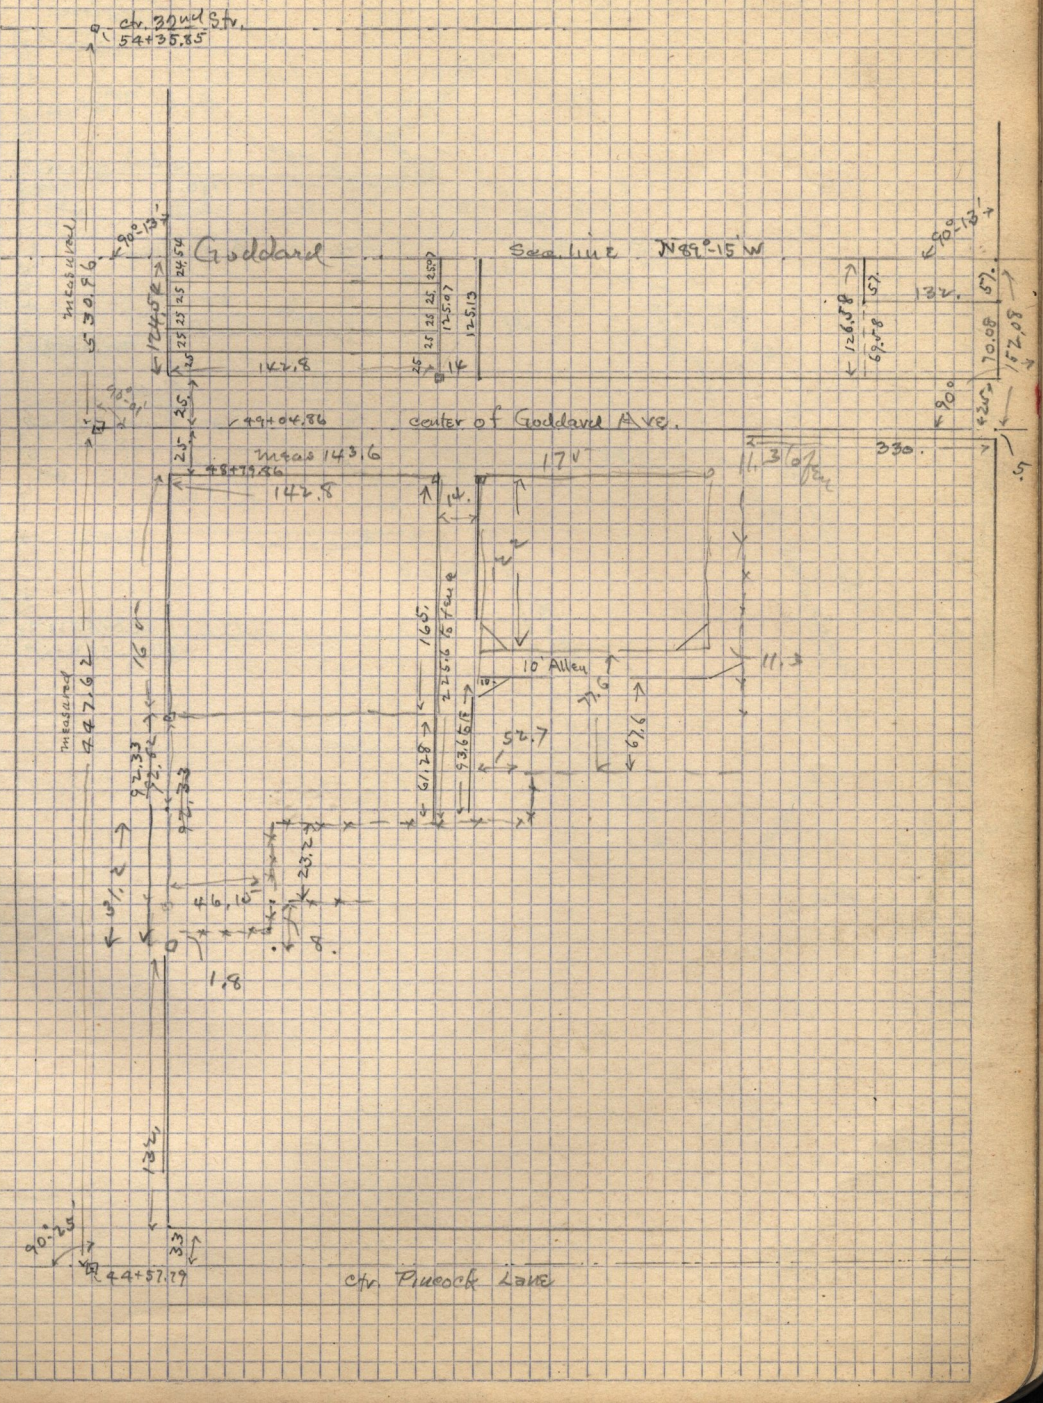
143.68 E & W. Lot 36-Blk 36. Ft. U.S. to 20. ft. Alley.