


May 8 - 1910 -
 Survey for Lynns Ecclesiastical Ward

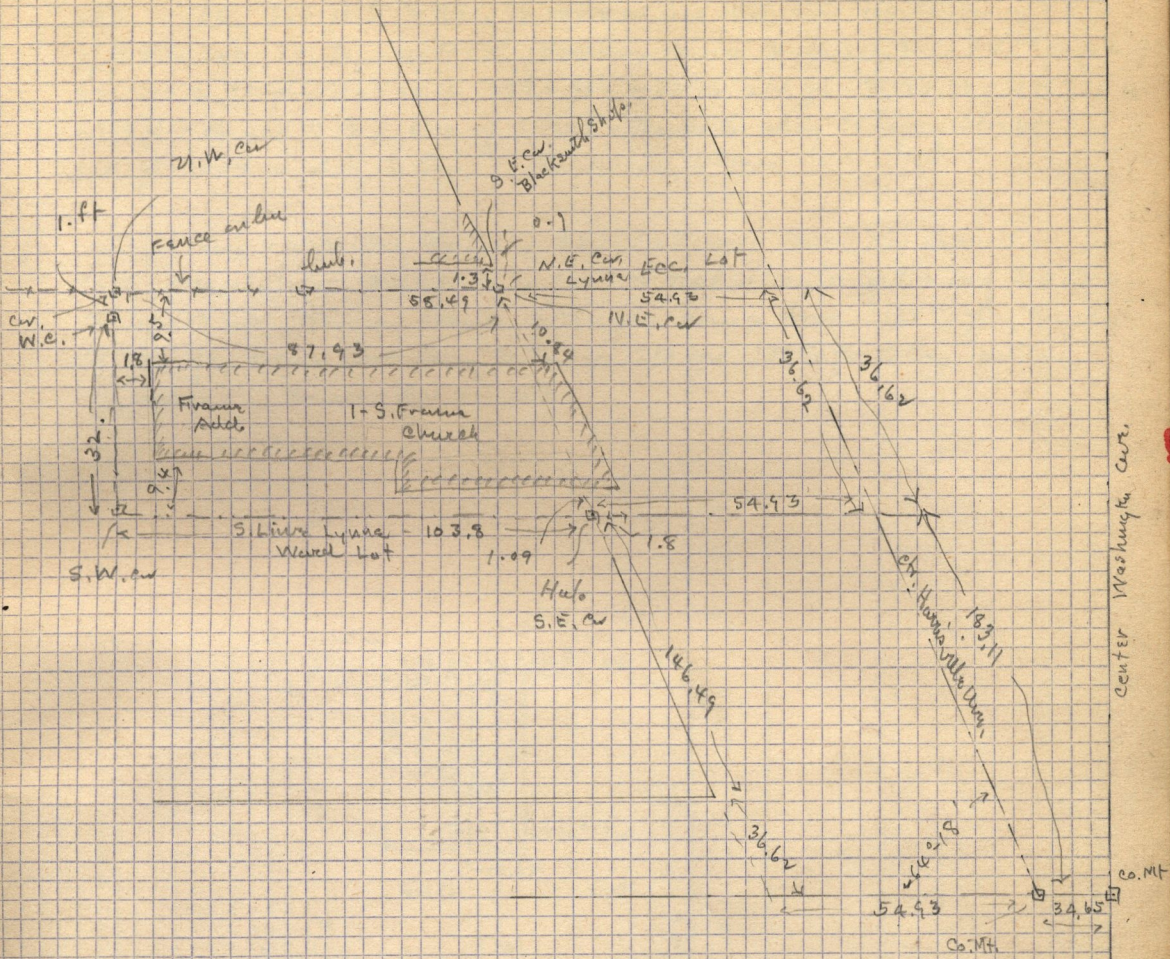

Center Washington Ave.

Co. Mt.