May 17-1910 - The day before the arrival of Comet,

35/226 (See sketch pages 11-13 and 14) 23

Wm W. Elmer to Chas E. Ziemer & Mary E. Ziemer Dated Jany 6-1900
$800. - Beg. 364. ft. S. and 920. ft more or less West from the N.W. cor. of S. 8 1/4 of N.W 1/4 Sec. 20. Tp. 6 N - R. 1 W. Running thence South 810. ft. - S 45° W 62. ft N 77°-40' W 95. ft - N 6°-30' W 287.0 ft - N 53° W 214. ft - N 30. ft - N 79°-30' W 162.0 ft - thence N to S. line of Street - Thence E. along S. line of Street 520. ft. more or less to beg. Recorded Jany 6-1900.

45/62 Joseph Parry & wife Olive Ann Parry to Charles Ziemer - Dated Nov 6-1903 -
$625. Beg. at a point 331.0 ft S. and 866.3 ft. West of center of N.W. 1/4 of Sec. 20 Tp. 6-N-R. 1 W Running thence S 796. ft - thence West 138 3/4 ft - thence N 796. ft. thence East along S. line of 12th Str, 138 3/4 ft, to beg, containing 2 1/4 acres Recorded Nov. 6-1903 -

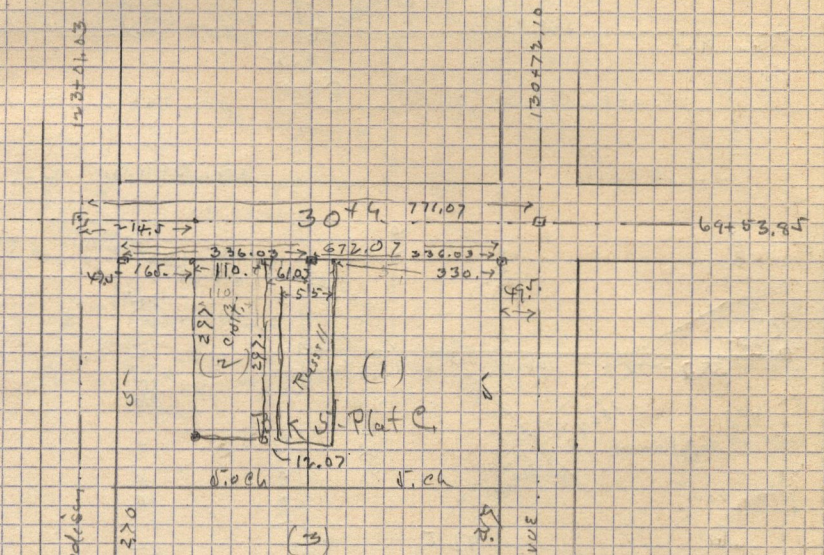

May 28- Survey of Blk 5 - Plat C. for — Russell et al