

May 18th + 19th 1910

City Mt 20th St

Survey for S.S. Howard - Part of Lot 2 - Blk G -



J. Stoddard Asst. S. D.

(As recorded Book 30 - p. 491)

Certificate M.C.
May 20th 1910
25.00

24

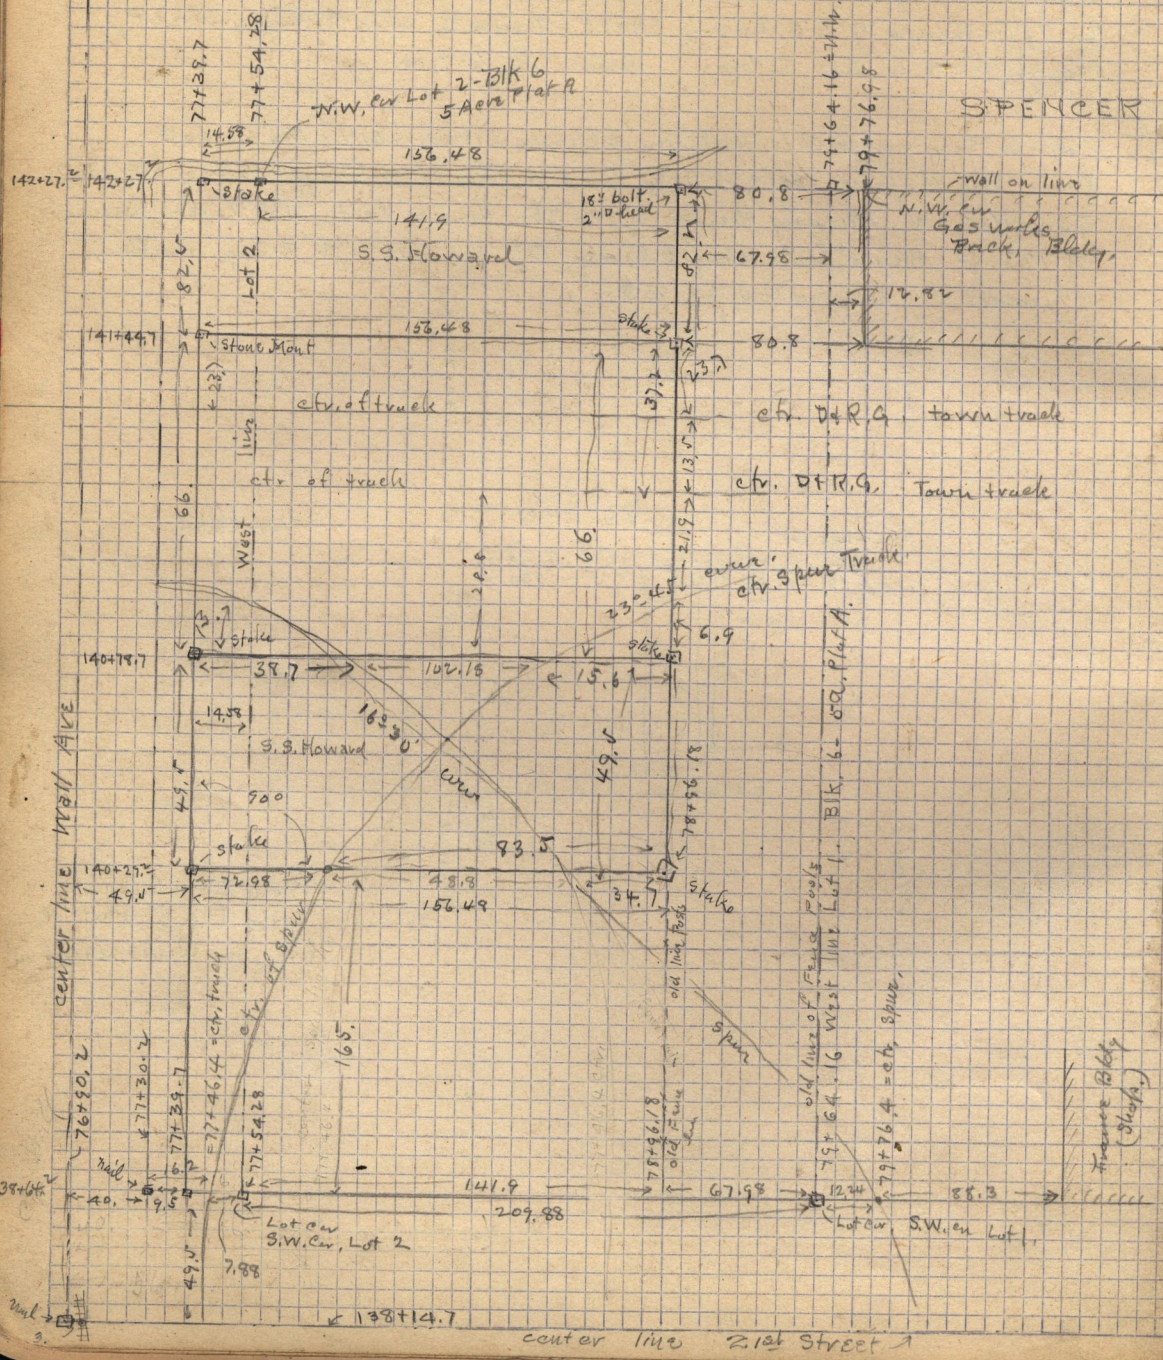

SPENCER S

entr. spur track

old line of Fence Posts
19th + 64.16 West line Lot 1. Blk G - Plat A.


center line 21st Street

