


26

June 23- 1910  
Survey of Burch farm S.W. 1/4 Sec. 5 Twp. 5 - R. 1. W. 17

References to spike

N.E	32.3	cr. but
S.W	9.0	n. gate post
S.W	20.2	S. gate post

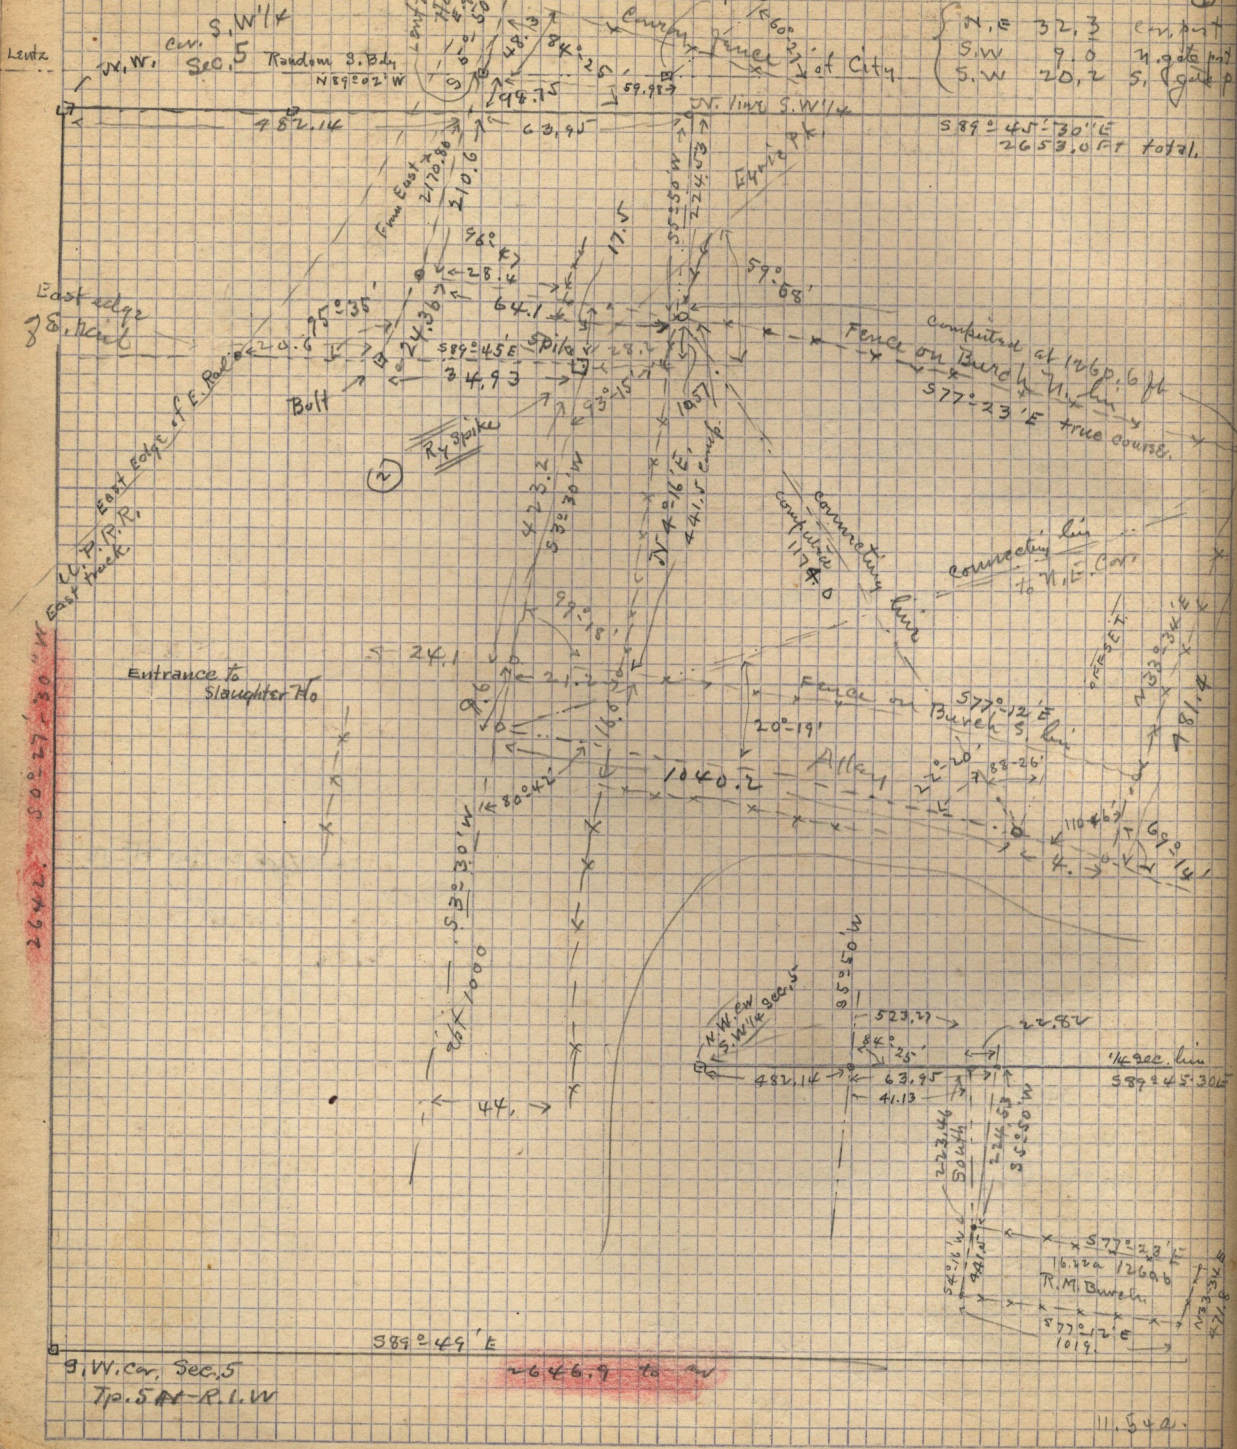

2642.80±27.30 W

2646.9 to ad

11.540.