July 10 - 1910 - Survey for Arthur M. Gregor & Brothers in Lot 15 - Blk. 10 - S.O.S. - W. A. Harrop assist.
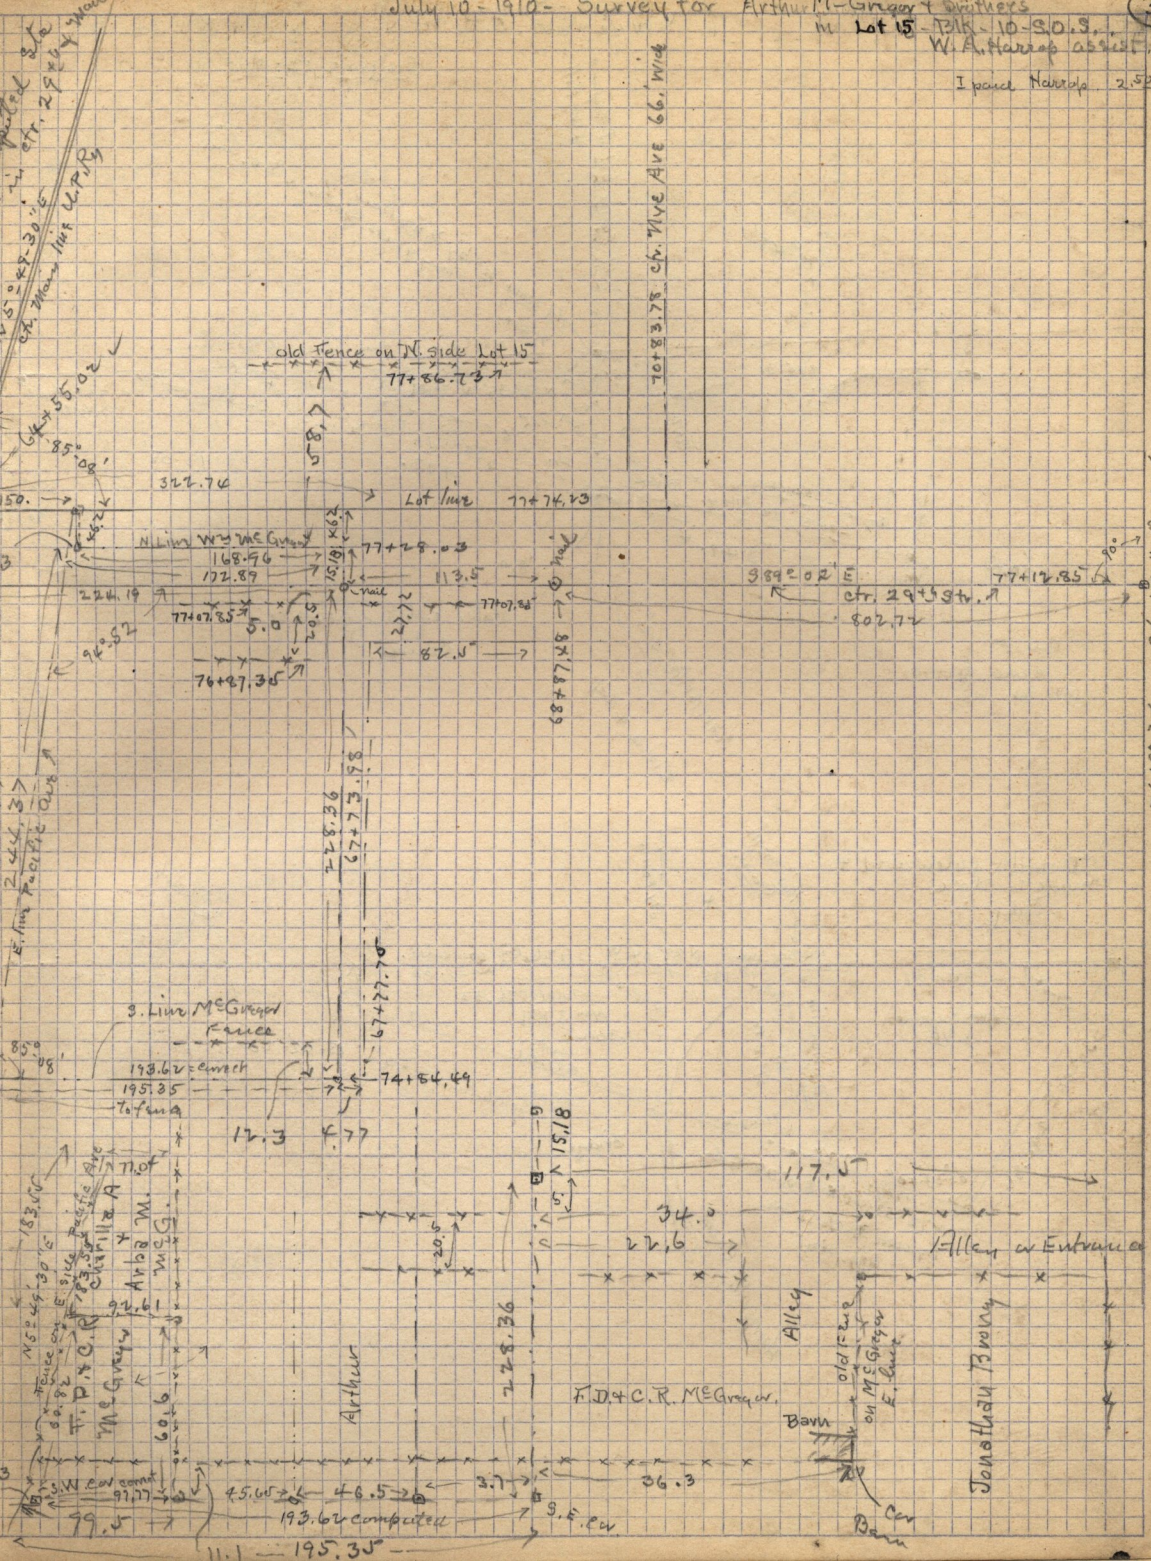
I pace Narrow 2.52