July 11-1910 - Survey for James Roylance in S.W. 1/4 - Sec. 5 Tp. 16-N - R. 1. W & Wm John Hill.
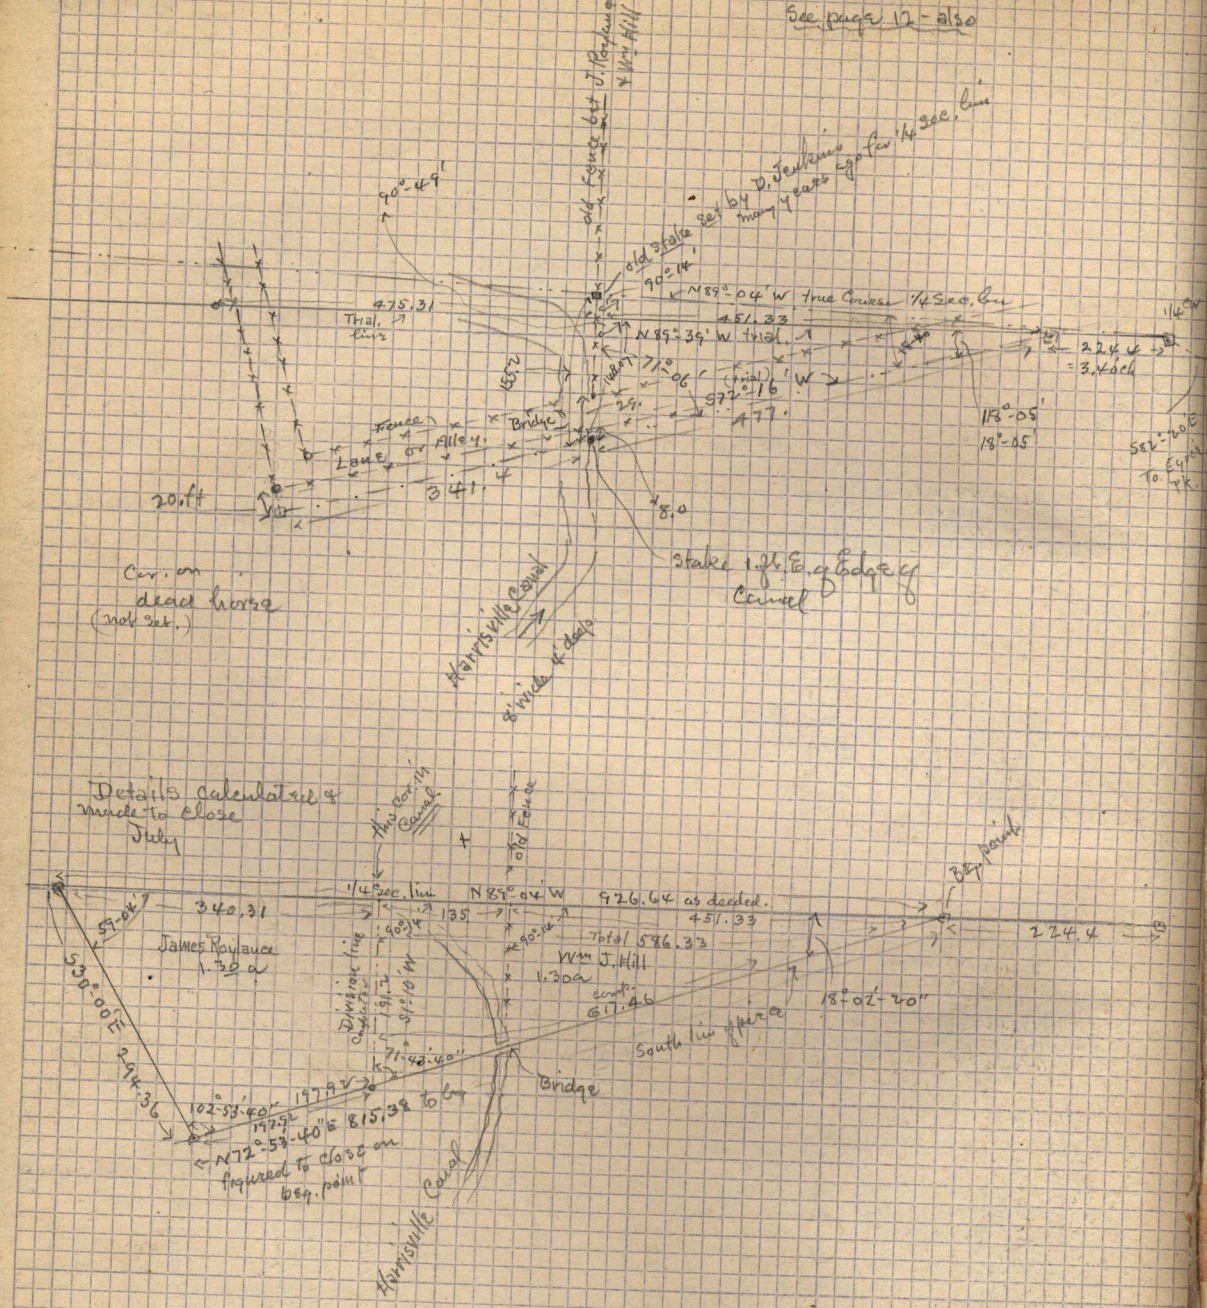
See page 12 - also