

original deed - Beg 165 ft. W. of S.E. cor. of Lot 1
 W. 38.75 more or less to pt of 131.25 ft. E.
 of S.W. cor. Lot 1; N 16. roads E 38.75 more
 or less to N.W. cor. S 16. roads to Cor.

Smith deeds to Episcopal Church
 Beg. 165 ft. W. of S.E. cor. Lot 1 - W 235 ft.
 N 140 ft. E 235 5140. to Cor.


Smith to Covington Co. 165 ft. W. of S.E. cor. Lot 1
 N 14 ft. W 235 514. E 235 to Cor.

Smith to J.A. Smith Co. 165 ft. W. of S.E. cor. Lot 1
 N 14 ft. W 235 514. E 235 to Cor.

Present description of remainder is as follows
 Beg. 167.85 ft. W. of S.E. cor. Lot 1 +
 thence W. 35.9 ft. more or less to point
 131.25 ft. E. of S.W. cor. of Lot 1 - North 154. ft.
 E. 35.9 ft. more or less to N.W. cor. S 154. ft.
 to Cor.

The foregoing figures 34.4

Certificate of survey made
 to E. A. Smith
 Oct 25-1910.

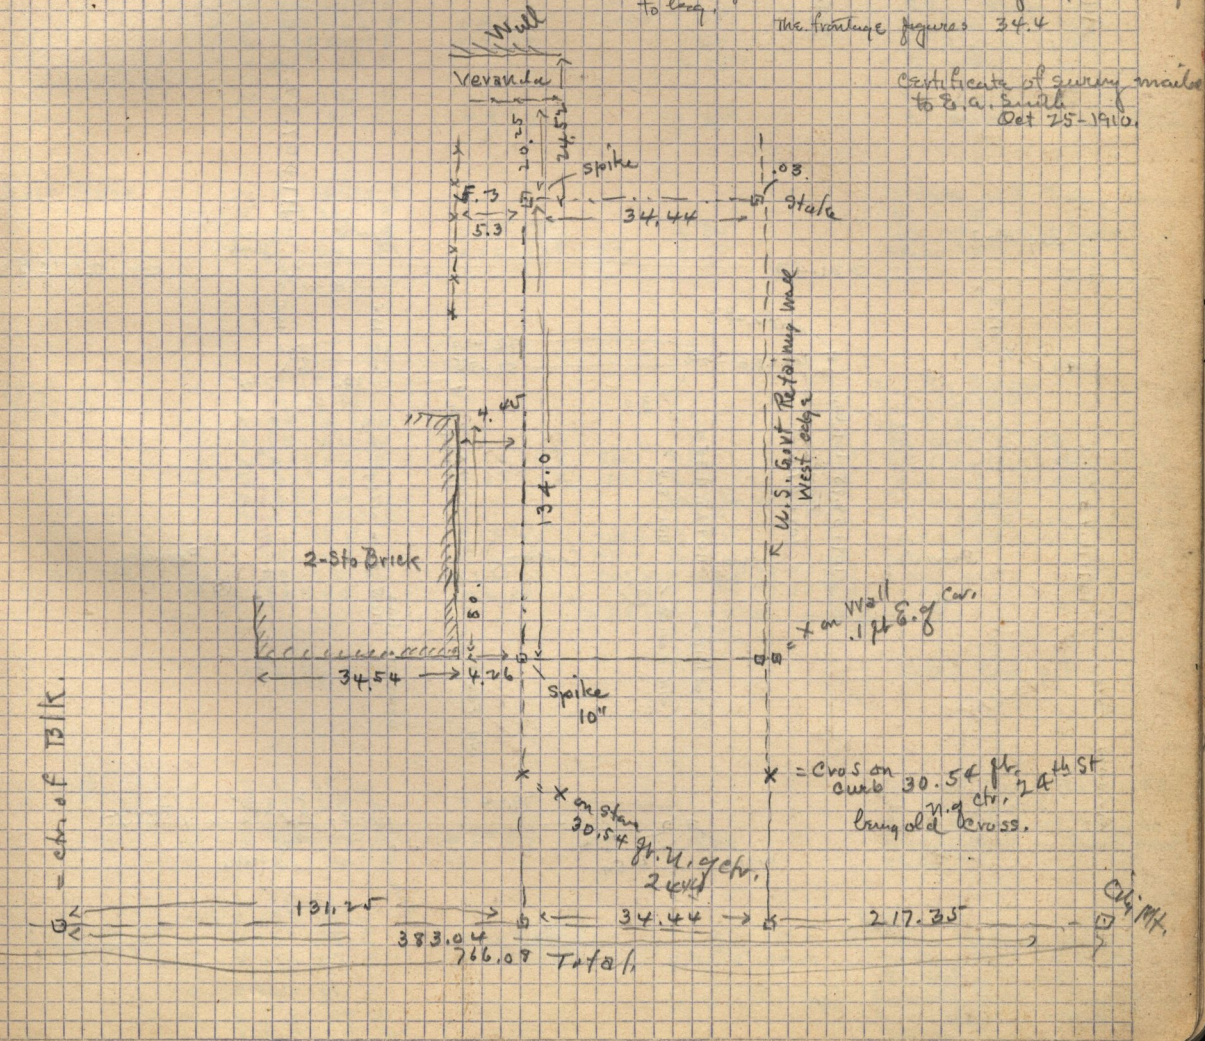

G = ch. of Blk.

City Mt.