(46)

Aug. 31-1910 - Survey for James A. Etherington at West Helena

X(?) p. 406 - Copy - deed from John Rogerson to Daniel Rogerson Sept 29-1888

Recorded 4 Oct 3rd 1888 - 1000. Pt N.W 1/4 Sec. 20 - T. 6 - N - R. 2 W.
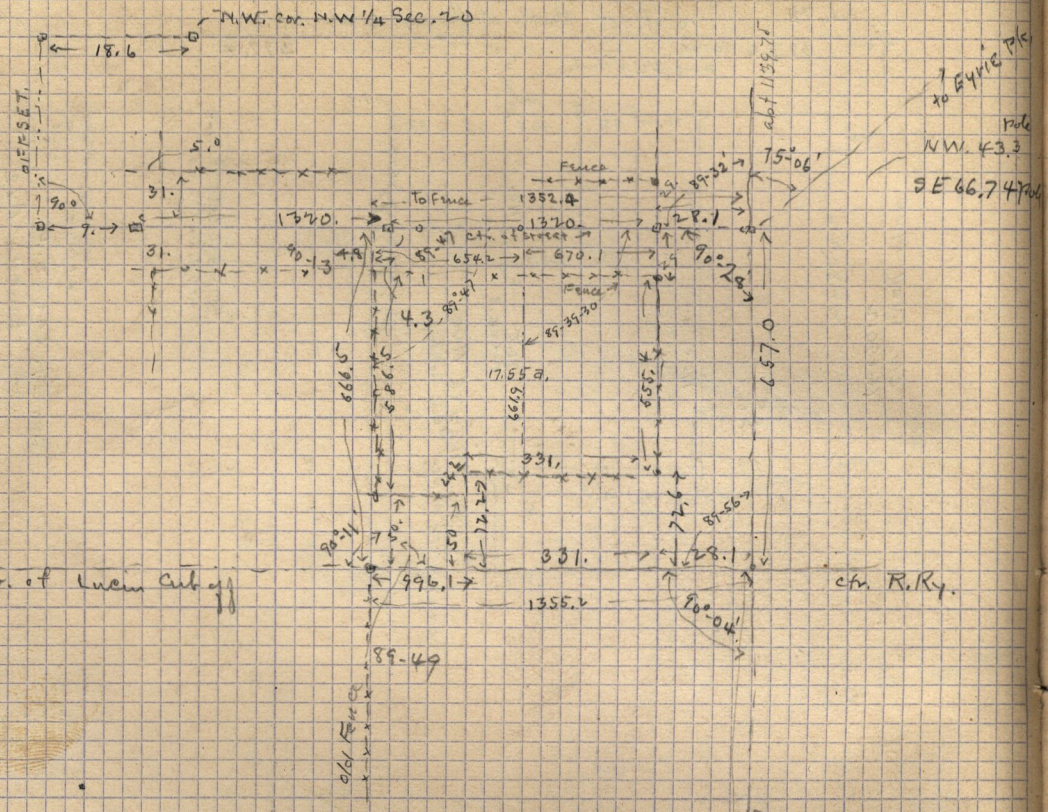
Beg. 30.41 chs S. of N.E. Cor. adj 1/4 Sec. - Thence S 7.49 ch - N 89° 36' W 20.00 ch
N. 10.00 ch - S 89° 36' E 14.77 ch - S 2.51 ch - S 89° 36' E 5.23 ch. to Beg.