


24th Str.


Sept 22-1910

Survey for 7000
Paid Fred Naisbitt 1.50 for help.

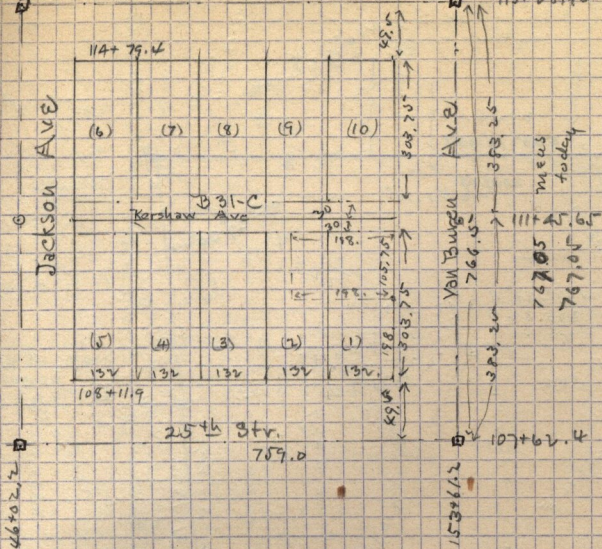

383.52
to City
Mth 1/4
24th St

City Capital

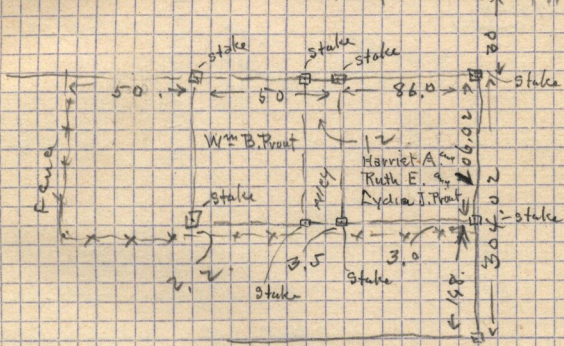

Van Buren

767.05 meas. to day

I find City hnd. in correct places & use

to City Mth