Nov. 14th 1910 - Survey for Mrs. James West.

Pt Lot 2 - B 32 - A. Beg. 93.5 ft E. of S.W. cor. of Lot - E 61. ft. 8" N 120 ft. W. 61. ft. 8" - S 120, ft. to beg. - R. of W. Beg. 93.5 ft E. of S.W. cor Lot 2 - E 236.5 ft. more or less to N.E. cor. Lot 2 - S 120. ft. to S.E. cor Lot 2 - W 7. ft. N 120. ft. more or less to 12. ft. S. of N. line Lot 2 - W 229.5 more or less to pt S. of beg. N 12. ft. to beg.

W. 42. ft. of above

{ Stake ordered set by Mrs. Nelson

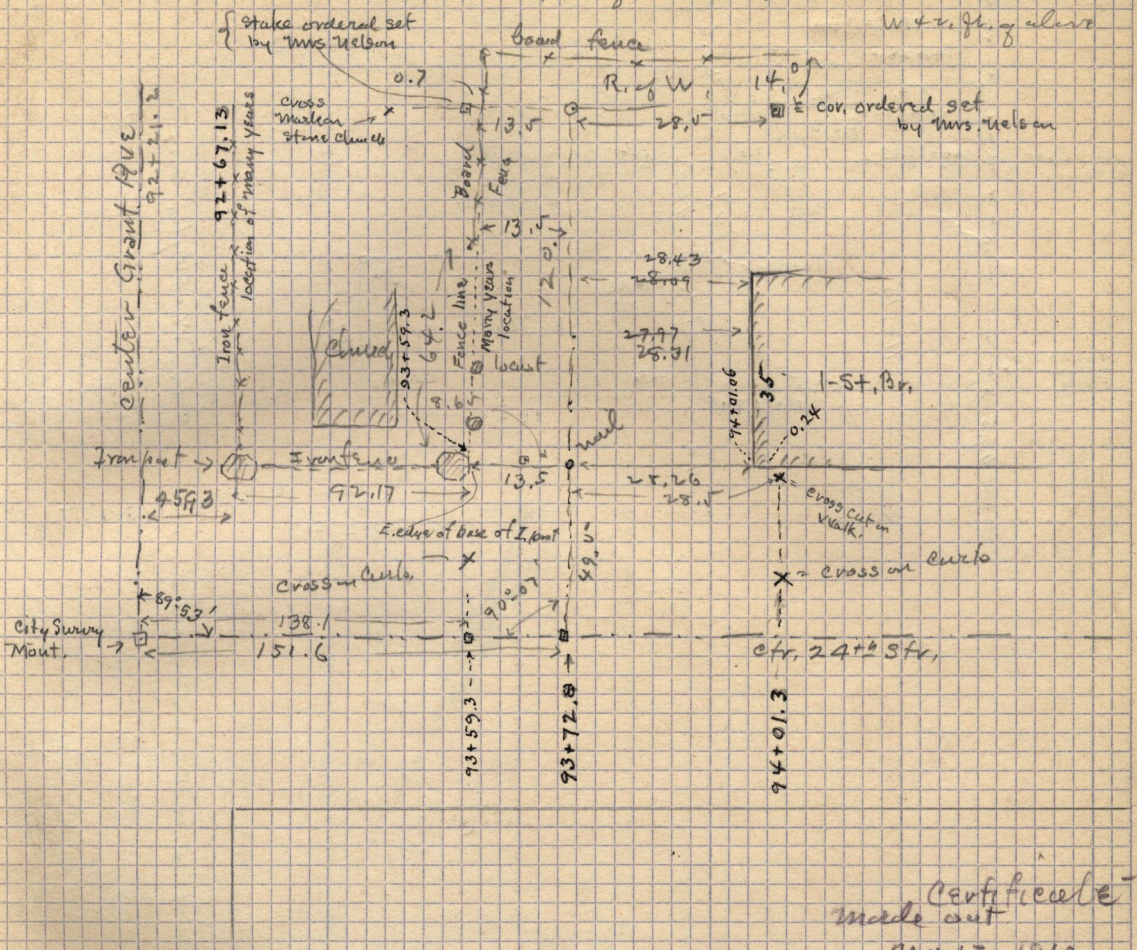

Certificate made out Nov. 17 - 1910.