

(65)


continuation of survey for Wheeler rights.

Nov. 30-1914

Wheeler State Land Co. L.

Wheeler River

South Bank

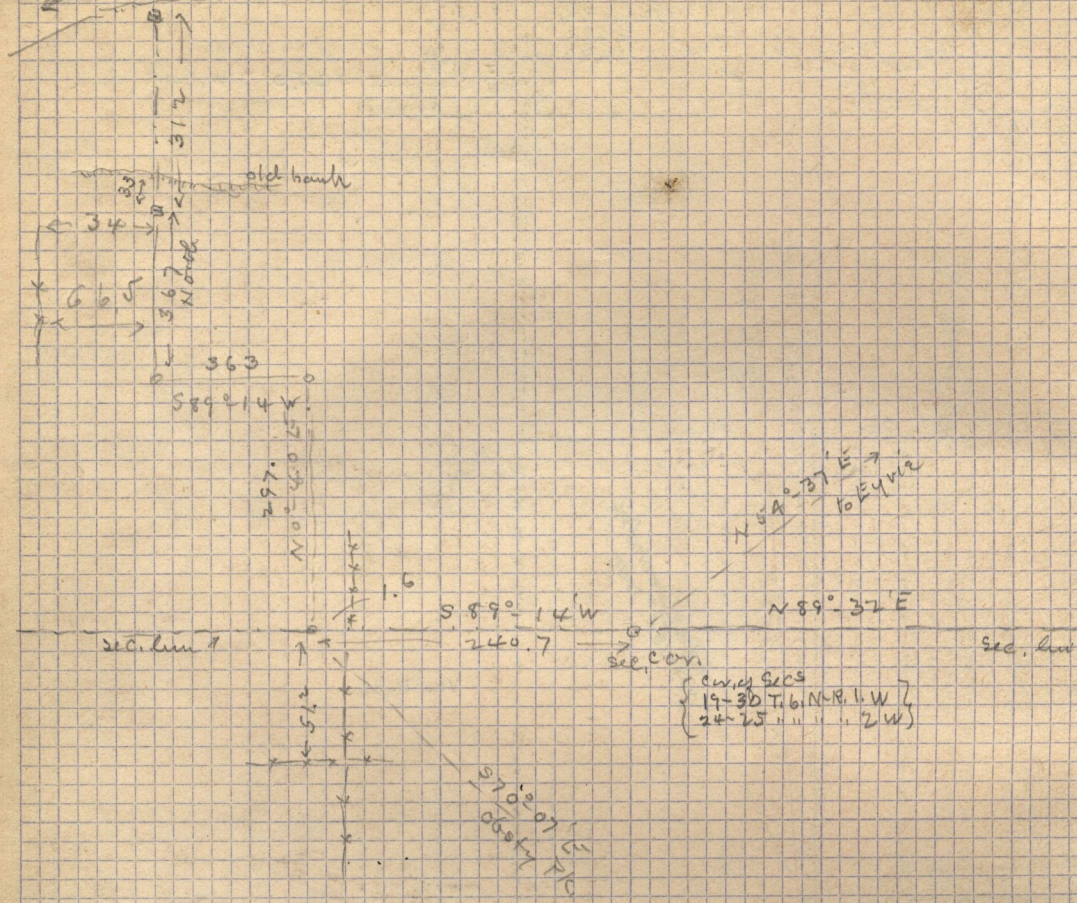

{ curvy Secs
 19-20 T. 6. N. R. 1. W }
 { 24-25 " " " " 2 W }