~~Dec.~~ Nov. 27 – Survey for Jas. C. Wangsgaard – in Sec. 34
Tp. 7 – N – R. 3. E

a copy of This Tp. is Eily Eng. Files 36/21

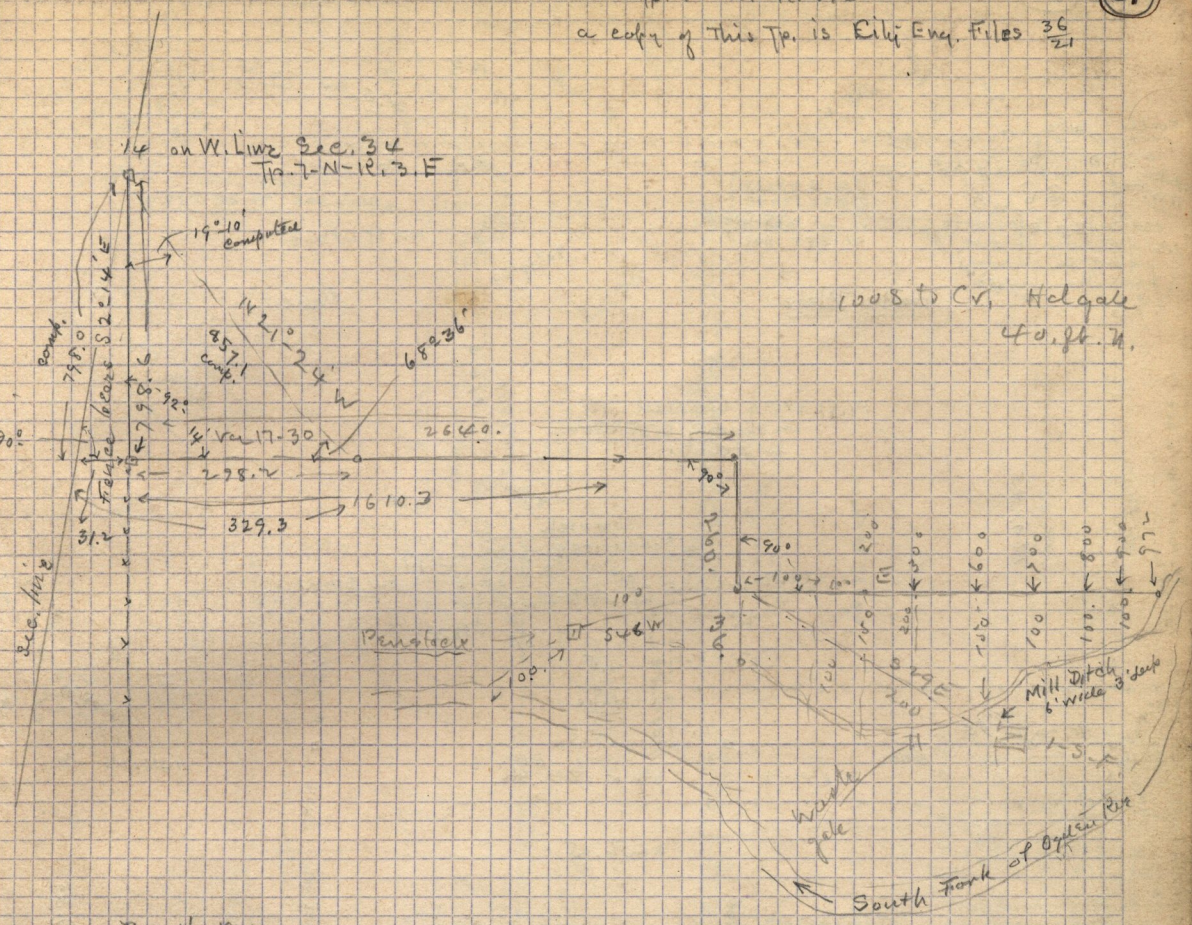

Dec. 16 – 1910

head of canal is 1018. ft. South & 3679. ft E. of N.W. Cor. S.W 1/4 said Sec. 34. in channel of South Fork of Ogden River thence following center of canal S 43° W ~~48.4~~ 53.8 ft – S 35° 45' W 123.2 ft – West 200. ft – S 63° 36' W 111.8 ft – S 80° 32' W 304.1 ft – N 63° 36' W 223.6 ft – N 57° 23' W. 118.7 ft – West 71.9 – S 33.4 ft. to Penstock – S 46° W 100. ft. to channel of South Fork end of tail race – at a point 1196.9 ft. South & 2527. ft E. of N.W. Cor. S.W 1/4 of said Sec. 34.

Traverse Table of above line

53.8		N	S	E	W
~~48.4~~	S 42° W		40.		36.0
123.2	S 35° 45' W		99.75		71.98
200	West				200.00
111.8	S 63° 36 W		49.71		100.14
304.1	S 80° 32 W		50.00		299.97
223.6	N 63-36 W	99.42			200.28
118.7	N 57° 23 W	63.98			99.98
71.9	West				71.9
33.4	South		33.4		
100.0	S 46° W		69.46		71.93
		163.40	342.32		1152.18